

70 000
FREE

DEC 3 1994


WATER RESOURCES DEPT.
SALEM, OREGON

"CERTIFICATE NO

1921

11

Application No. R-77213
Permit No.

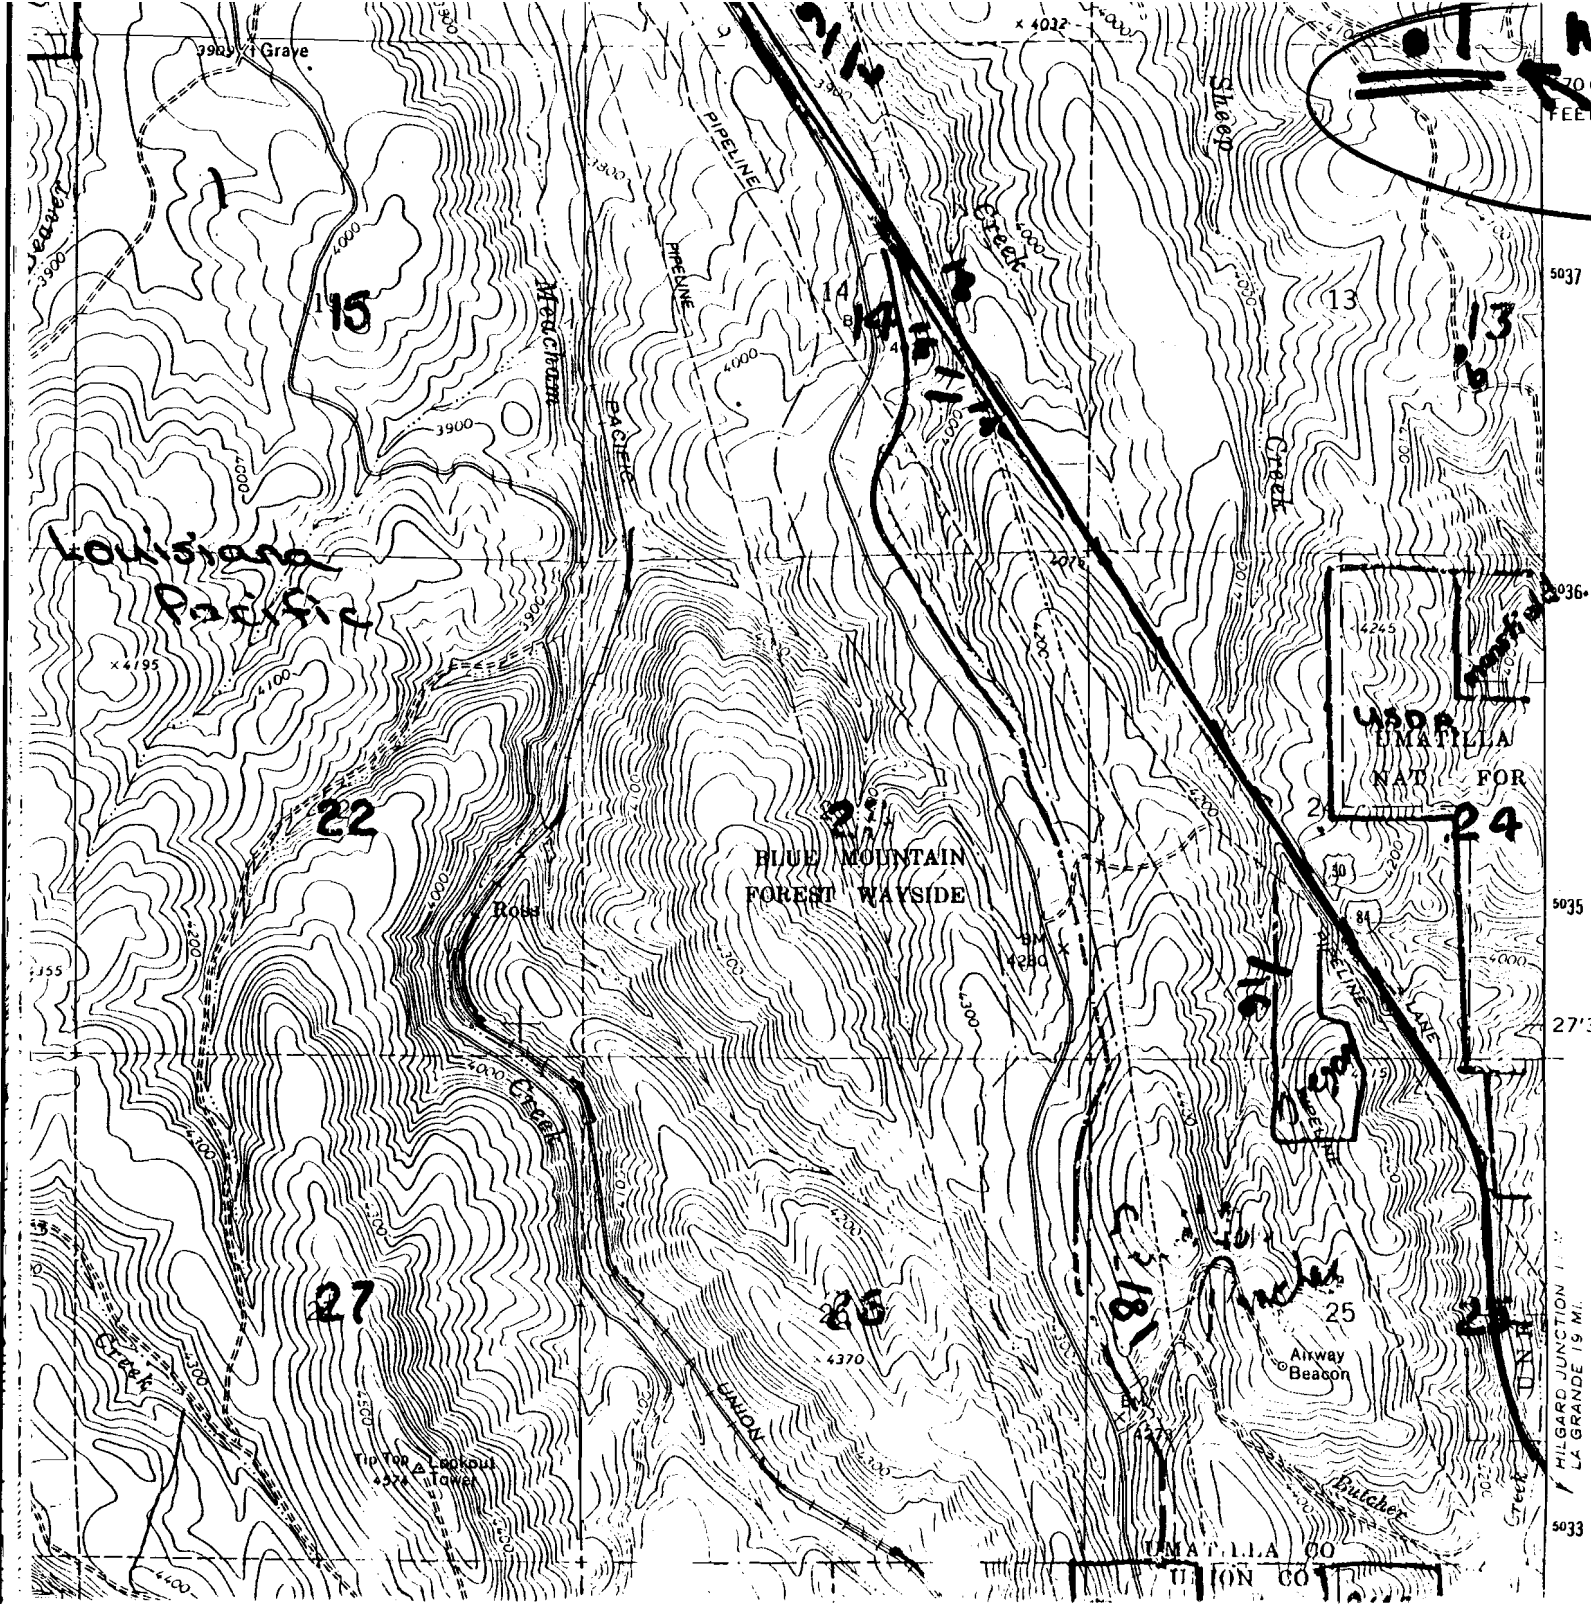

RECEIVED


DEC 30 1994

WATER RESOURCES DEPT.
SALEM, OREGON

"CERTIFICATE NO. _____"

10043

Application No. R-77212
Permit No.

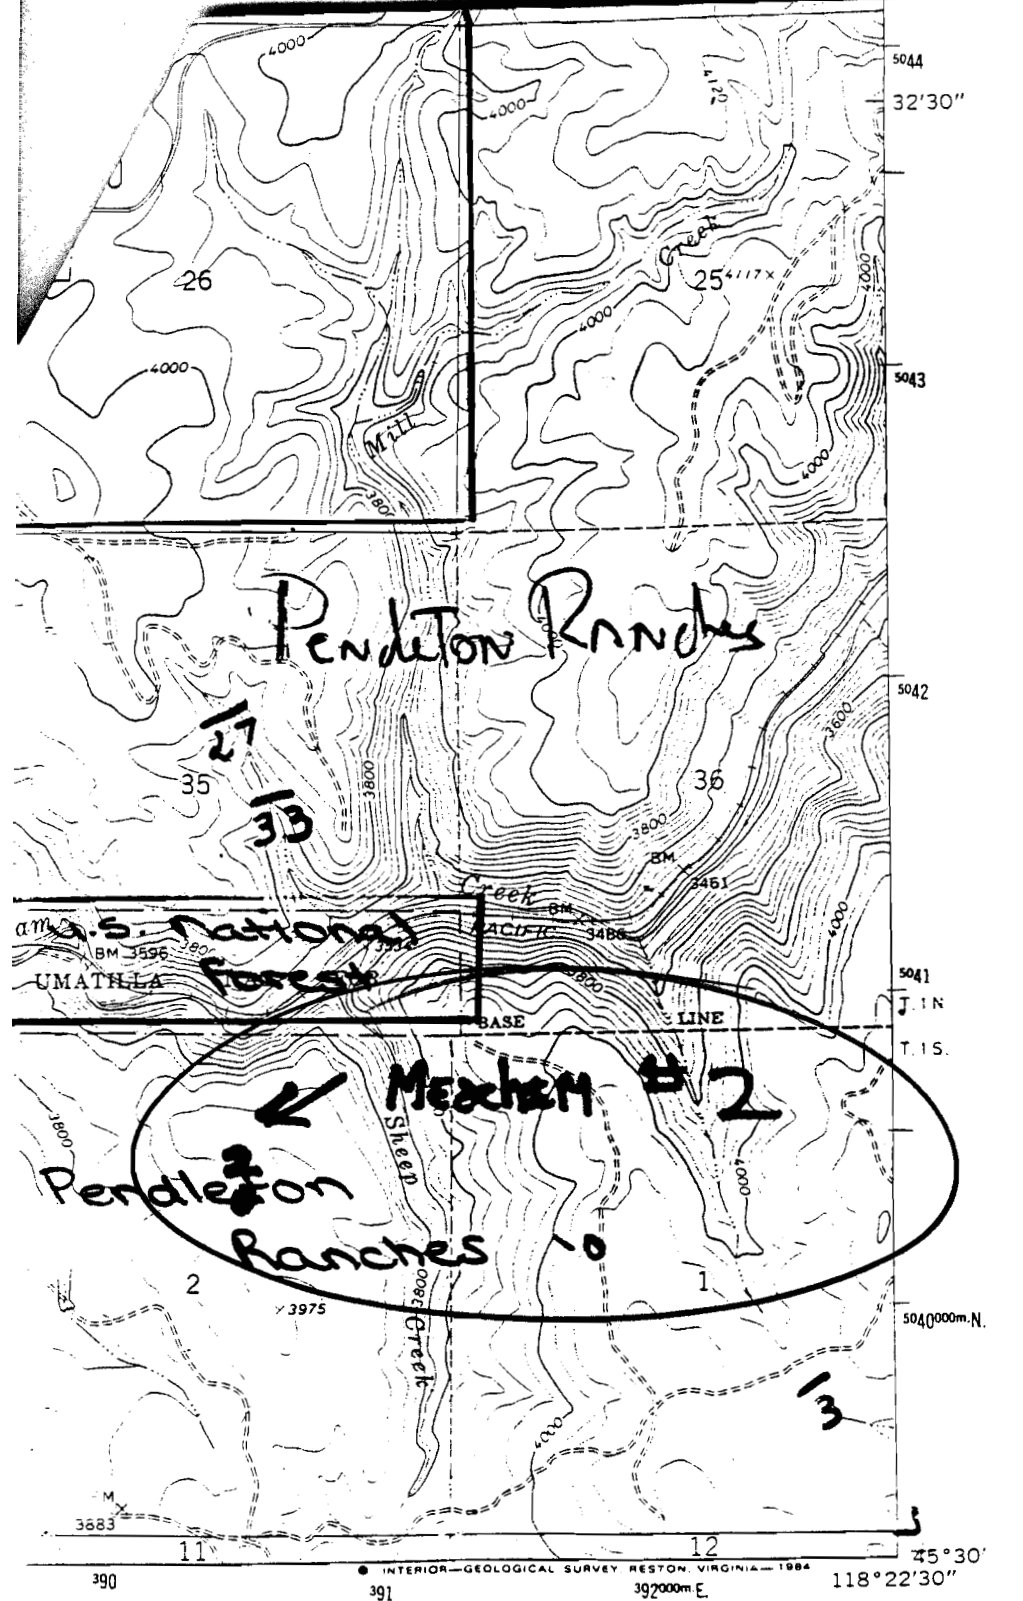

ROAD CLASSIFICATION

Heavy-duty _____ Light-duty _____
Medium-duty _____ Unimproved dirt _____

Interstate Route U.S. Route



QUADRANGLE LOCATION

shown in purple and woodland compiled from
photographs taken 1981 and other source data
checked by U. S. Forest Service. Map edited 1983

MEACHAM, OREG.
45118-E4-024

1964
PHOTOREVISED 1983
DMA 2375 III SW-SERIES V892


UNITED STATES
DEPARTMENT OF THE INTERIOR
GEOLOGICAL SURVEY

DEC 30 1994

SALES DEPT.
SALEM, OREGON

118°22'30" 45°30' 393 R. 35 E. 36 E. 394000m. E.

HORN
#4

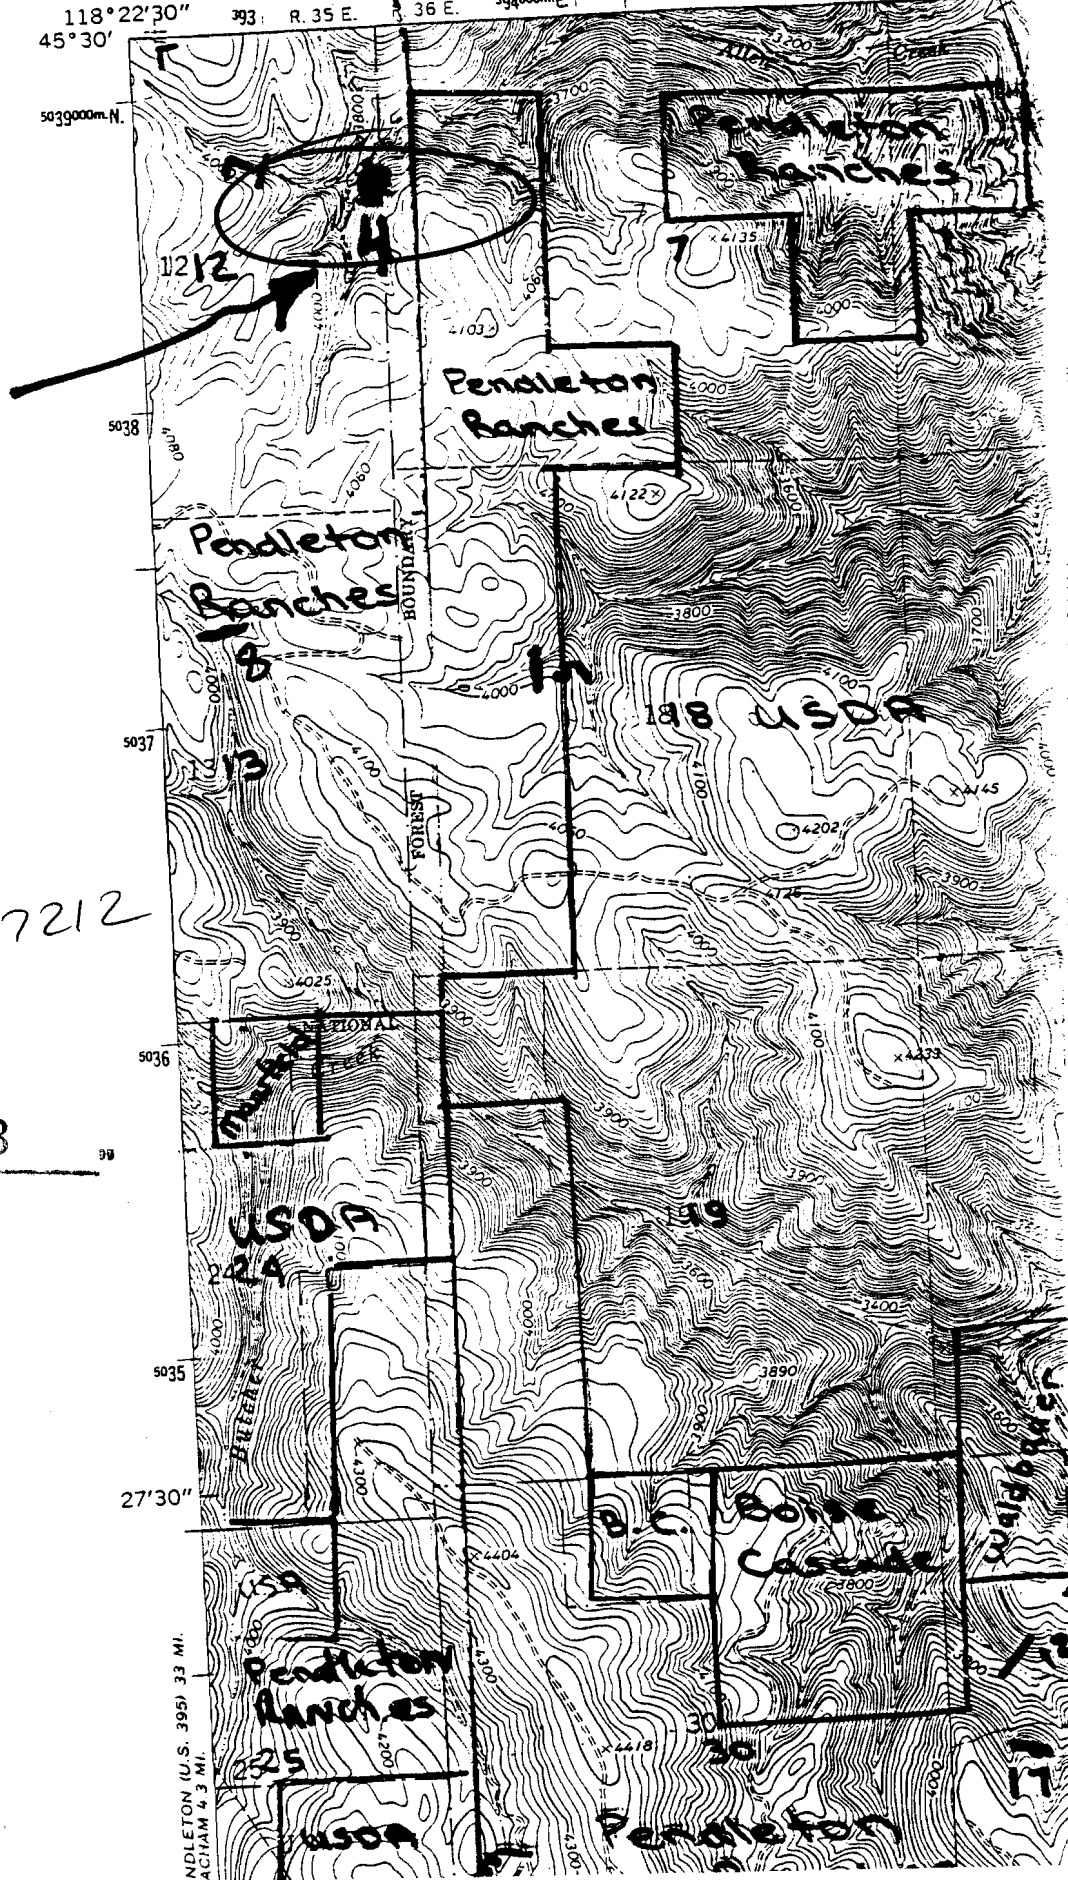

Application No. R-77212
Permit No.

CERTIFICATE NO. 70013

4

2375 11 SW
(MEACHAM)

UNITED STATES
DEPARTMENT OF THE INTERIOR

RESEAR SURVEY


RECEIVED

DEC 30 1994

118° 22' 30" 393 R. 35 E. R. 36 E. 3940000m. E

WAILI 1135 SURCES DEPT

5039000m. N.

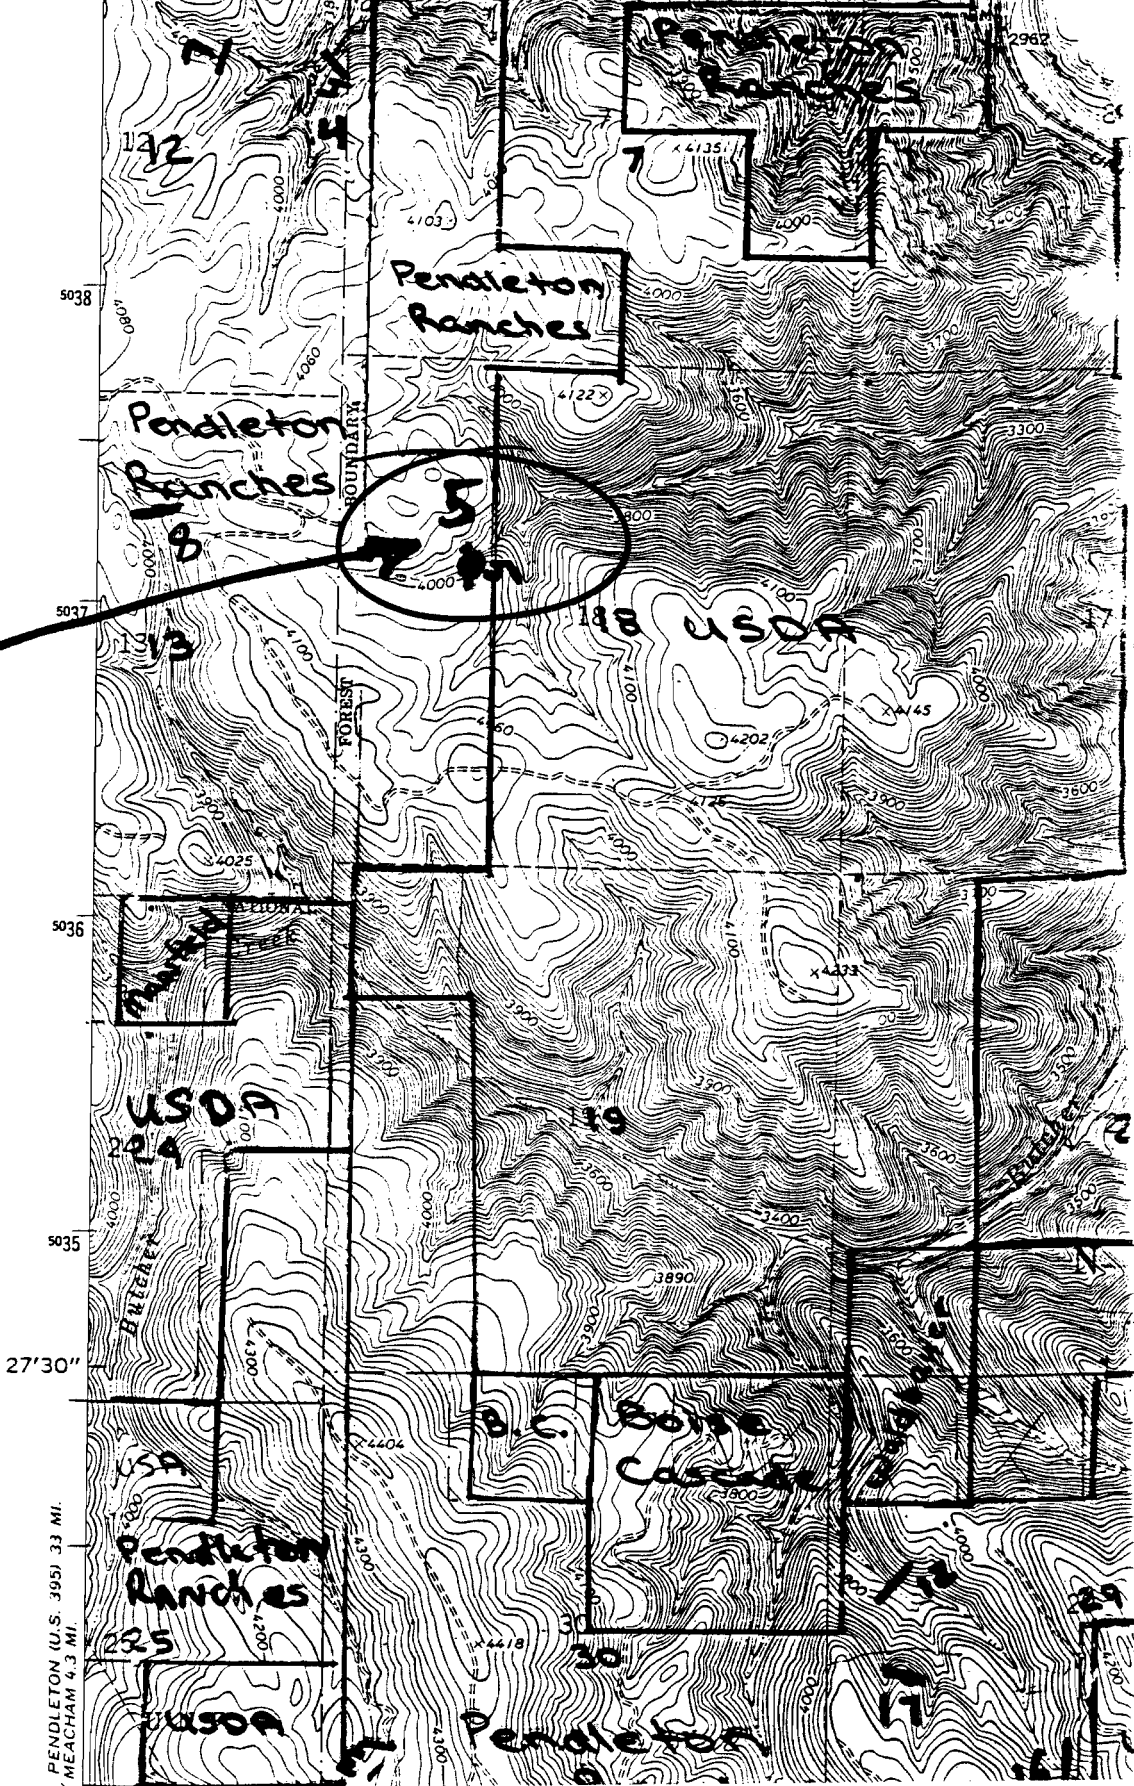

Huron
#5

CERTIFICATE NO.

10000

APPLICATION NO. K-77222
Permit No.

PENDLETON (U.S. 395) 33 MI.
MEACHAM 4.3 MI.

175 III SW
MEACHAM) 388

PENDLETON (U.S. 395) 28 MI.

25'

MEACHAM LAKE

MEACHAM LAKE QUADRANGLE
OREGON
7.5 MINUTE SERIES (TOPOGRAPHIC)

2 540 000 FEET


118° 22' 30"
45° 30'

2375 III SE
(DUNWAN)

RECEIVED

DEC 3 1994

WAT

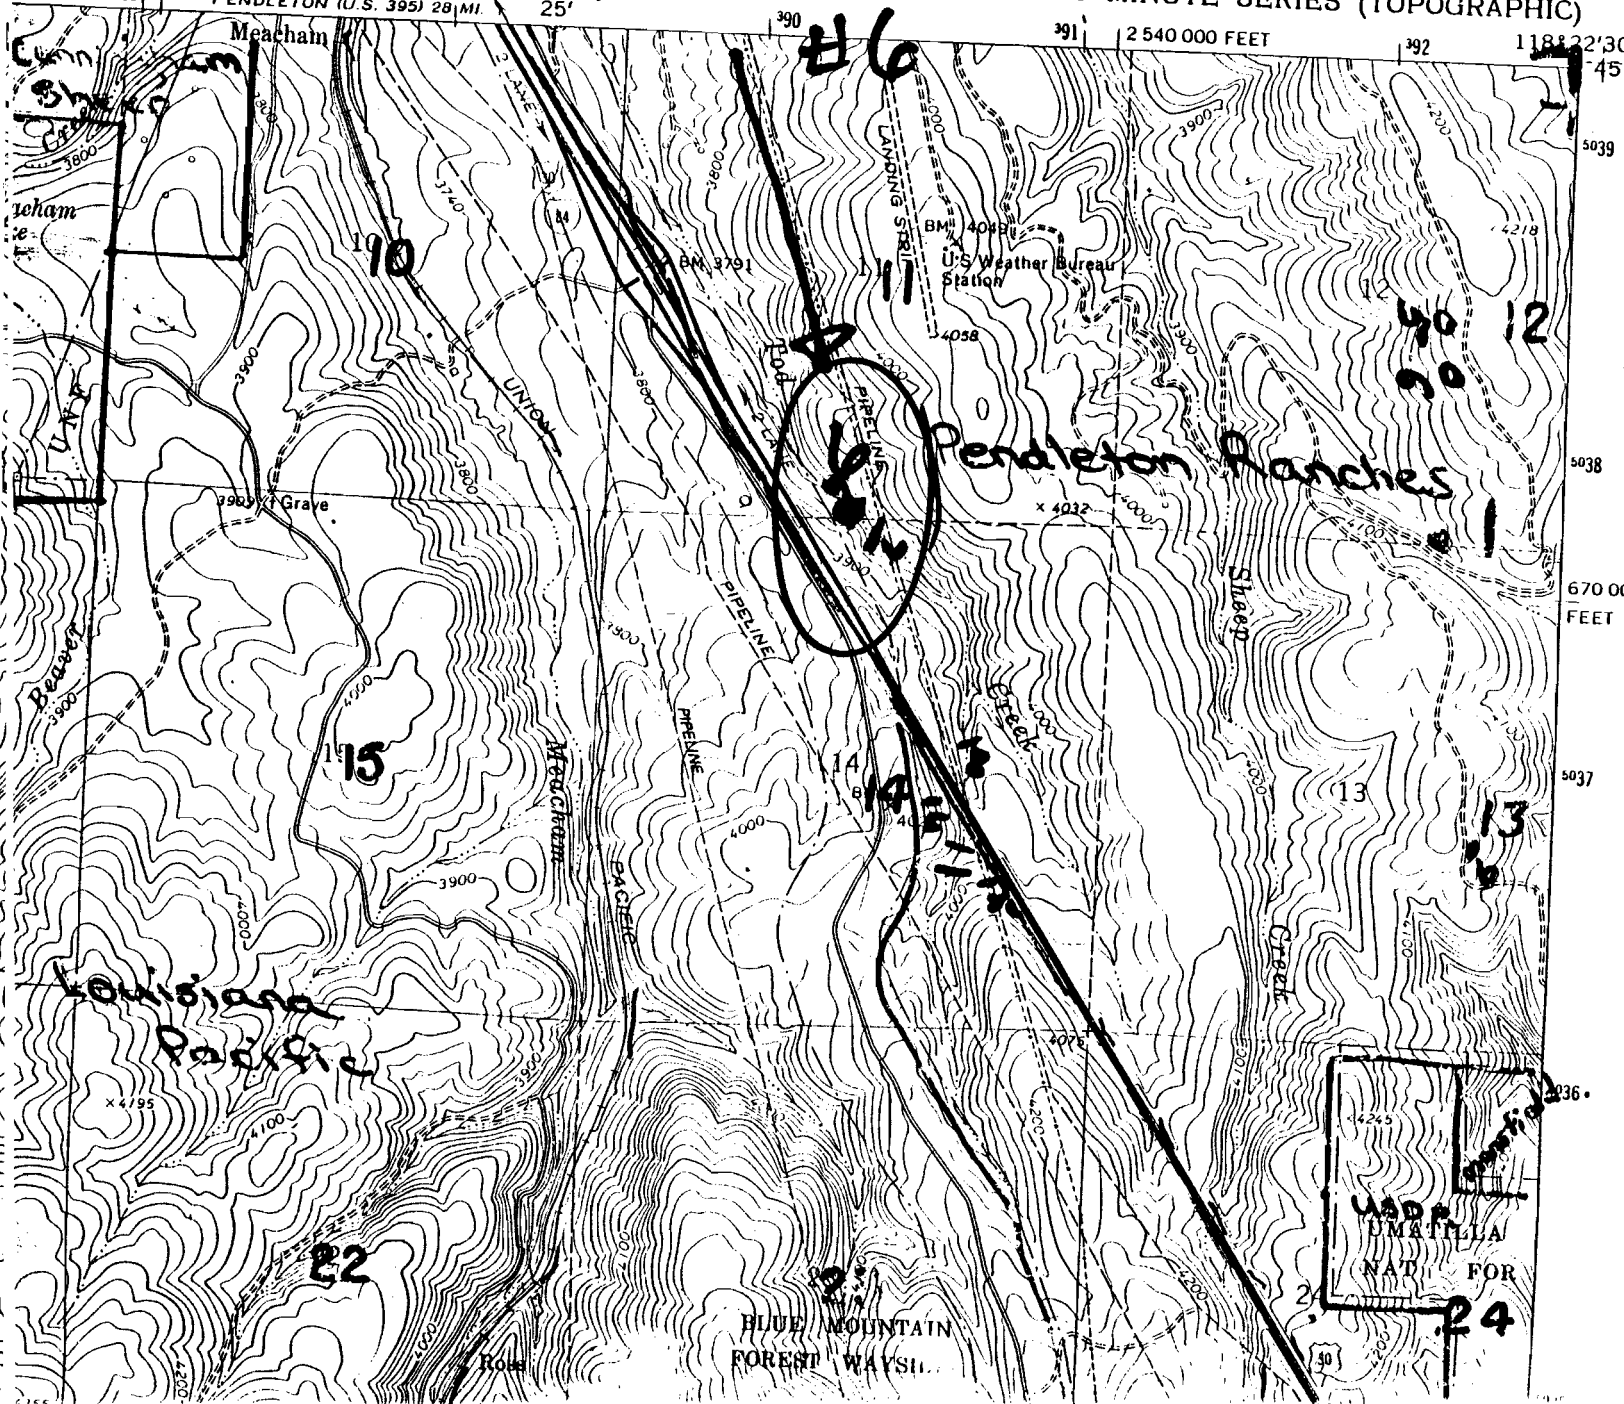

Application No. R-7212
Permit No.

7213

DATE

Meacham Lake

MEACHAM LAKE QUADRANGLE
OREGON
7.5 MINUTE SERIES (TOPOGRAPHIC)


2375 III SE
(DUNFAN)

75 III SW
MEACHAM) 388

PENDLETON (U.S. 395) 28 MI. 25'

2 540 000 FEET

118° 22' 30"
45° 30'

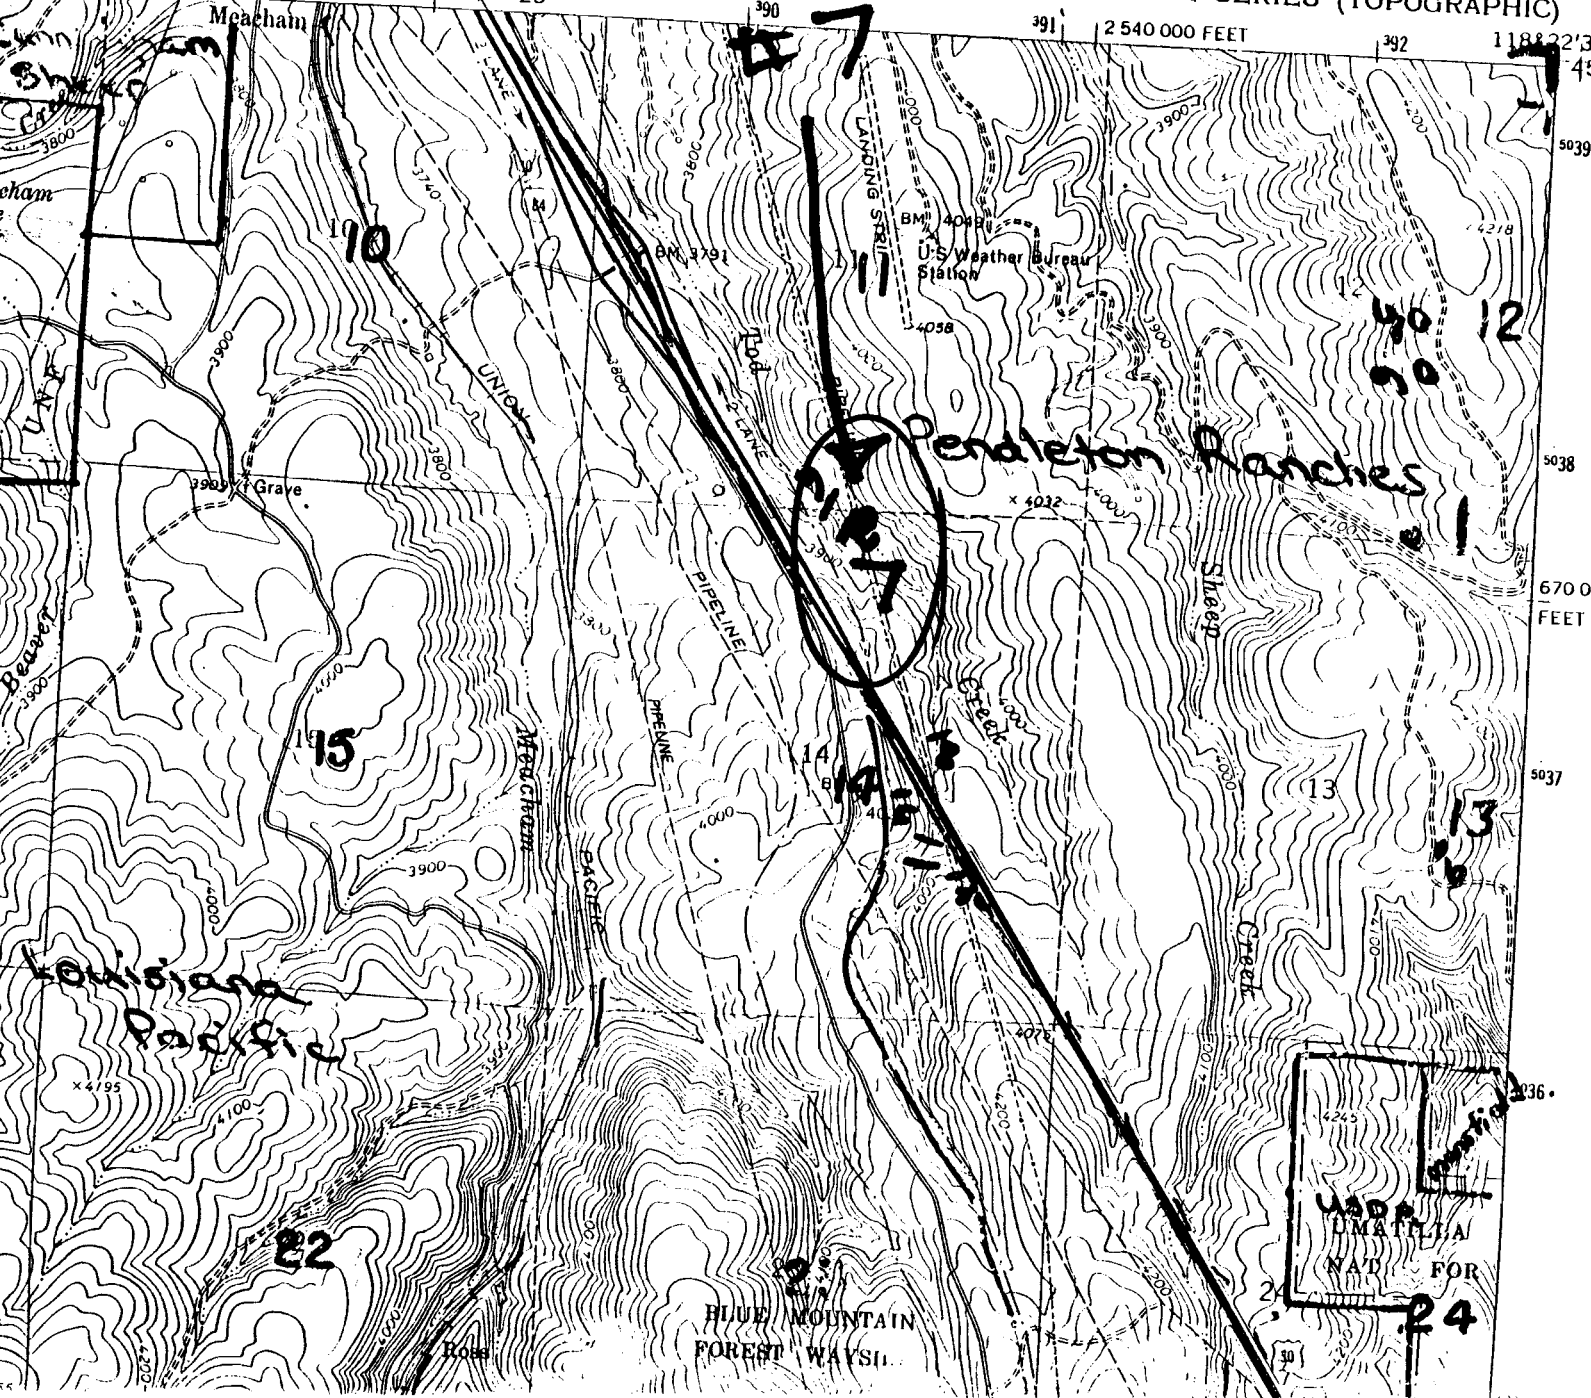

"CERTIFICATE NO. _____"

Application No. **677212**
Permit No. _____

SALEM, OREGON


DEC 30 1994

RECEIVED

MEACHAM LAKE QUADRANGLE
OREGON

7.5 MINUTE SERIES (TOPOGRAPHIC)

2375 III SE
(DUNEAN)

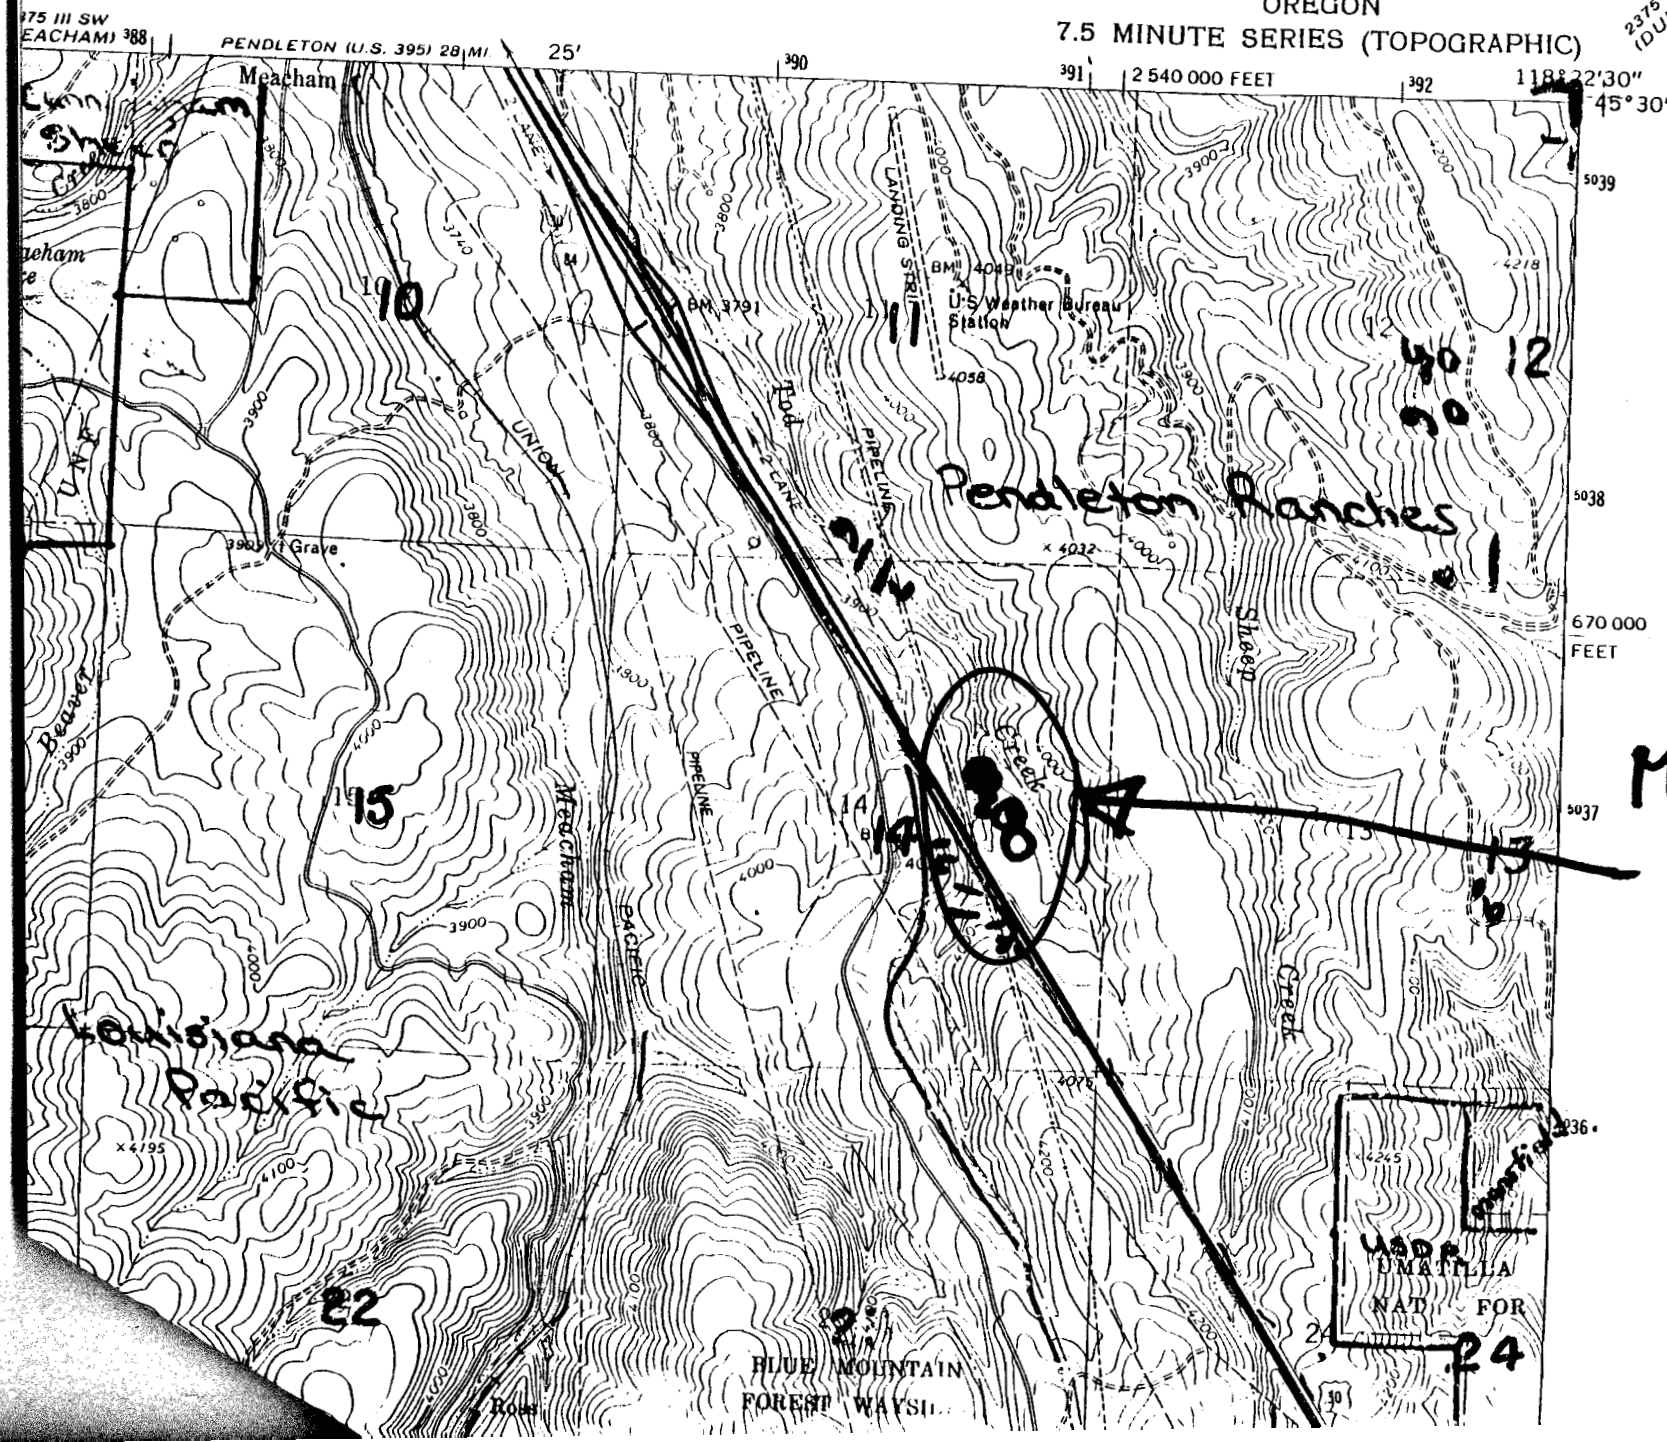

Meacham
Lake
#8

CERTIFICATE NO.

Permit No.

Application No. 6-77212

RECEIVED

DEC 30 1994

WATER RESOURCES DEPT.
SALEM, OREGON

70 000

DEC 30 1994

WATER RESOURCES DEPT.
SALEM, OREGON

Application No. A-77213
Permit No.

"CERTIFICATE NO

100

2

RECEIVED


DEC 30 1994

WATER RESOURCES DEPT.
SALEM, OREGON

CERTIFICATE NO.

70013

Application No. R-77212
Permit No.

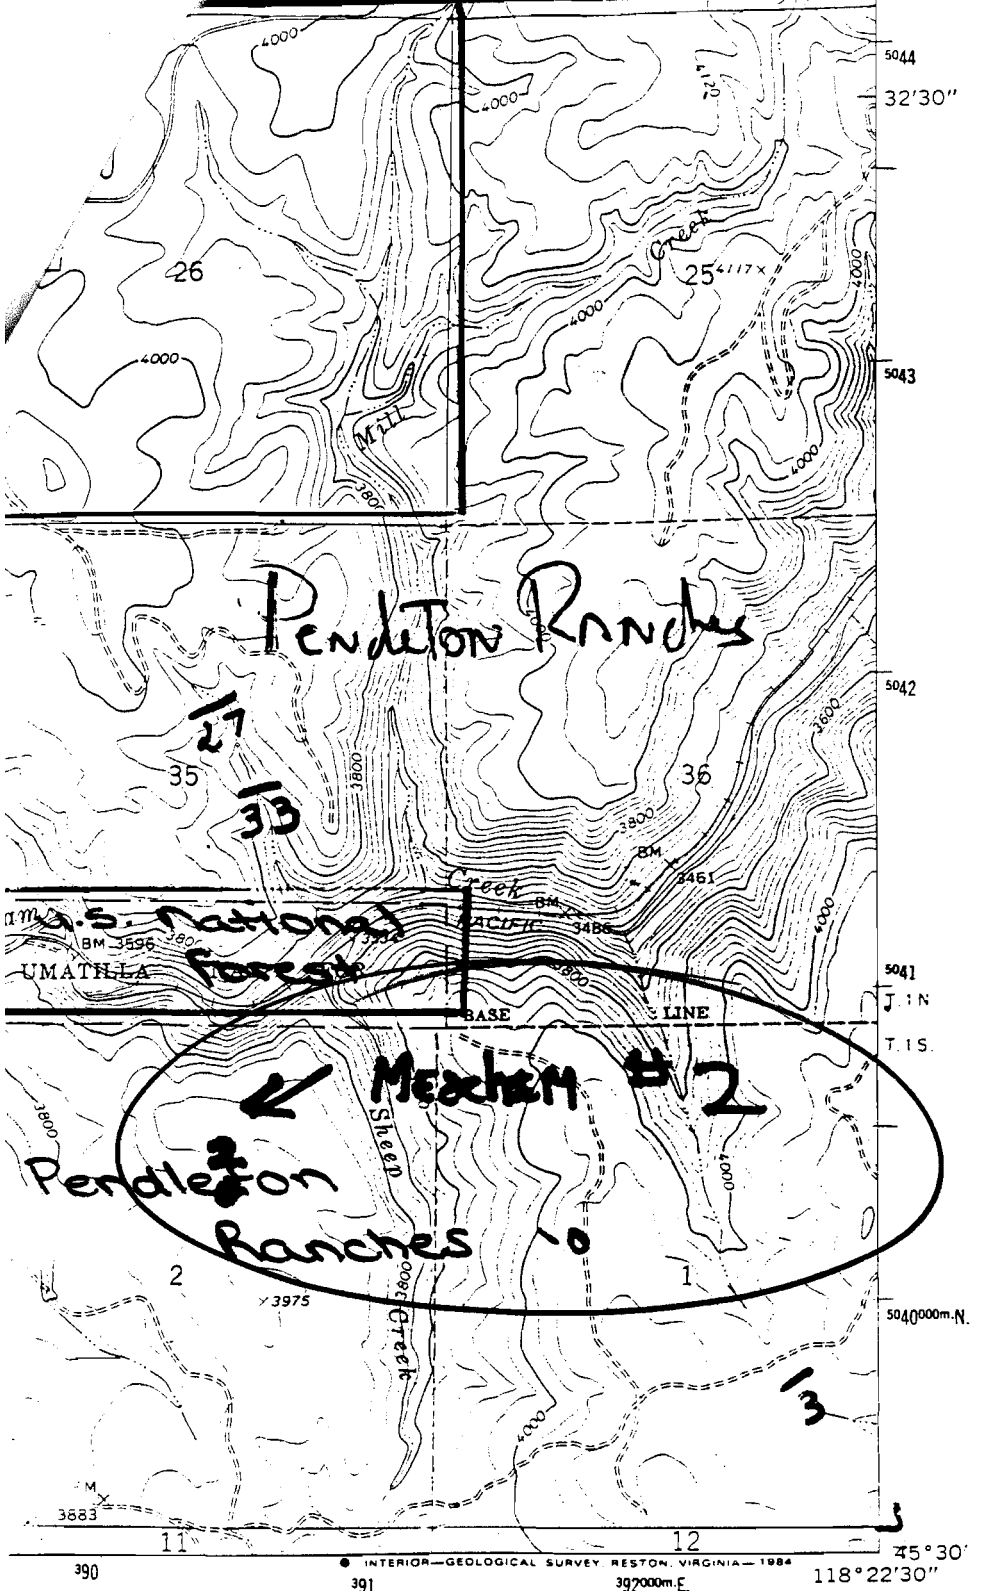

ROAD CLASSIFICATION

Heavy-duty _____ Light-duty _____
Medium-duty _____ Unimproved dirt =====

Interstate Route U. S. Route

meacham

MEACHAM, OREG.

45118-E4-024

1964

PHOTOREVISED 1983

DMA 2375 III SW-SERIES V892

OREGON

QUADRANGLE LOCATION

shown in purple and woodland compiled from
topographs taken 1981 and other source data
check by U. S. Forest Service. Map edited 1983

RECEIVED

UNITED STATES
DEPARTMENT OF THE INTERIOR

DEC 30 1994


GEOLOGICAL SURVEY

SALEM, OREGON

118°22'30" 45°30' 393 R. 35 E. 36 E 394000m E.

2272 11 SW
(MEACHAM)

HORN
#4

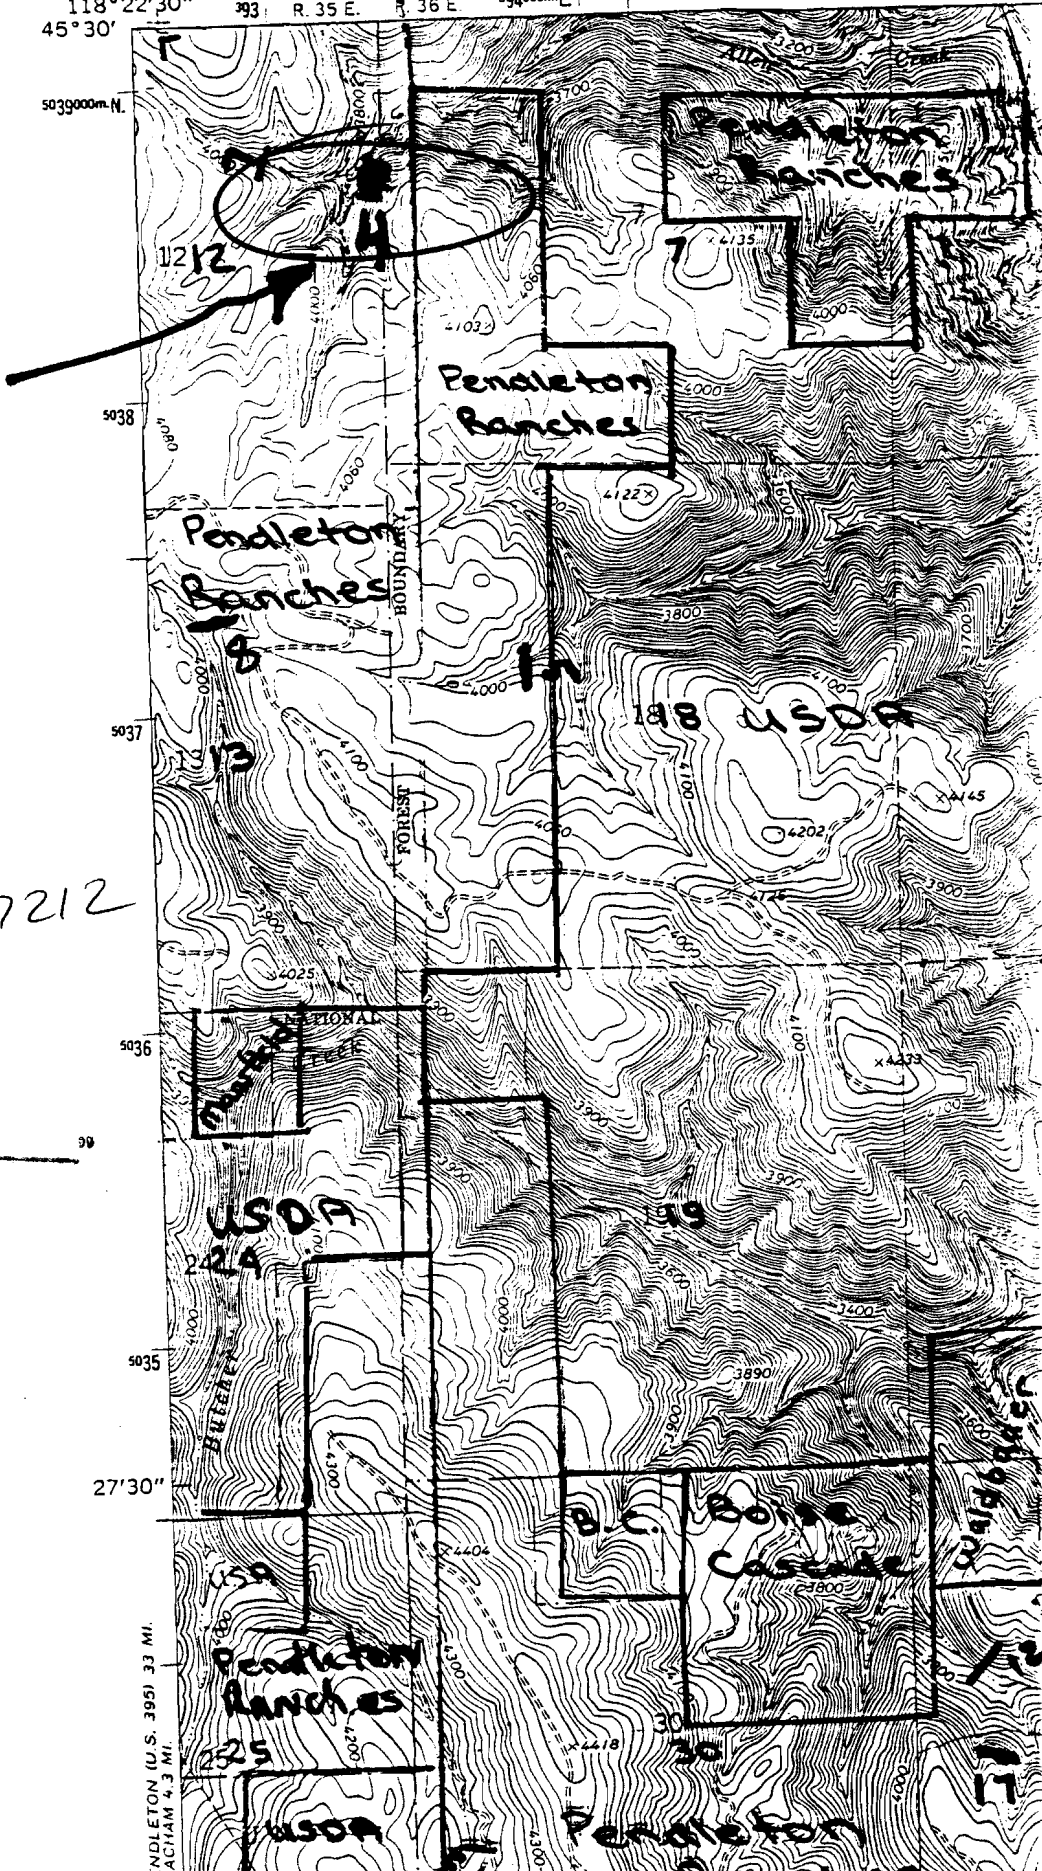

Application No. R-77212
Permit No.

CERTIFICATE NO. 77213


PENDLETON (U.S. 395) 33 MI.
ACHAM 4.3 MI.

2375 III SE
(DUNNAN)

DEC 3 1994

WA:

Application No. *R-7212*
Permit No.

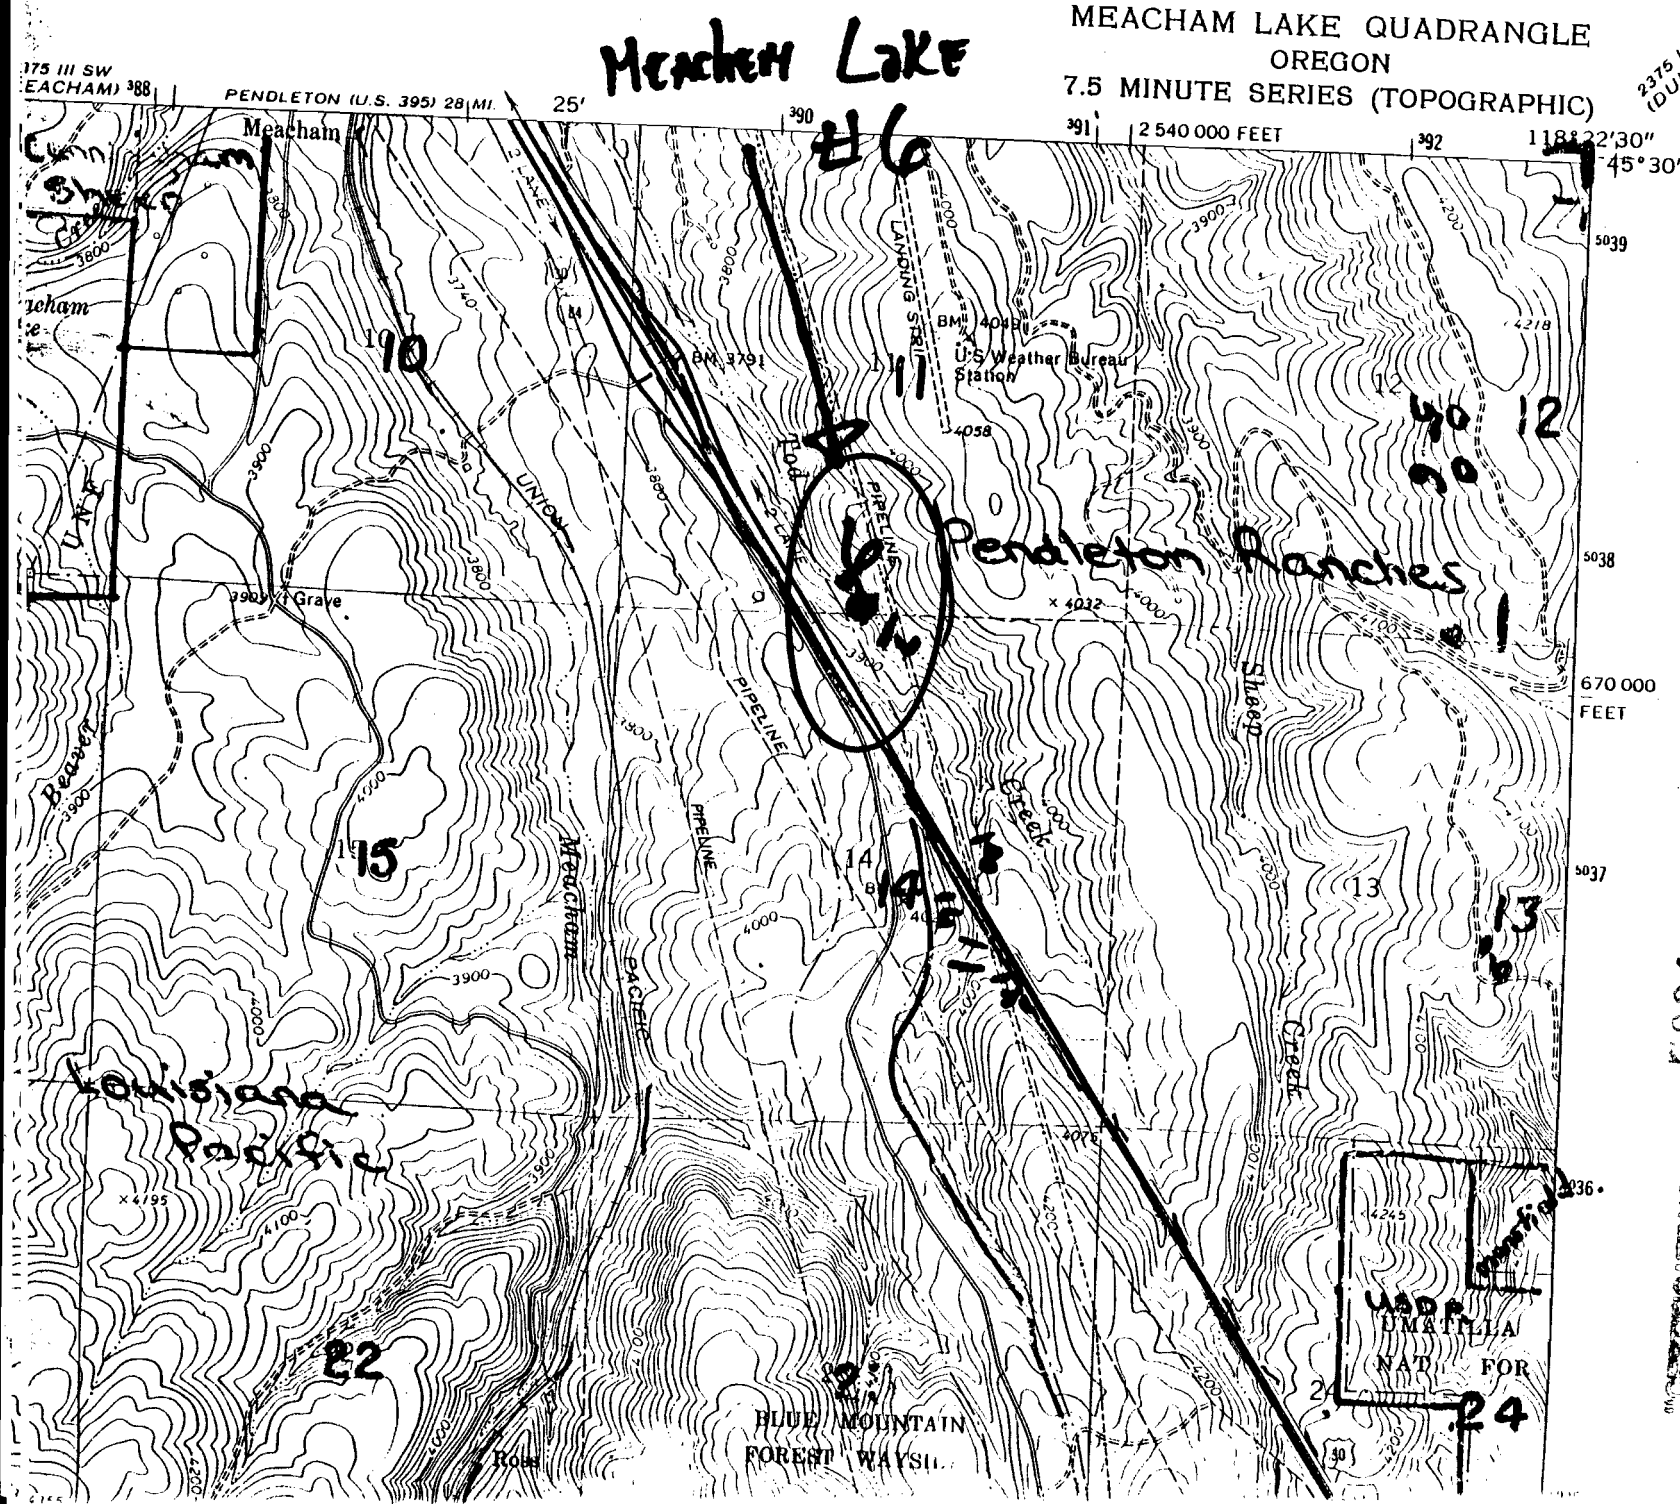

Meacham Lake

MEACHAM LAKE QUADRANGLE
OREGON
7.5 MINUTE SERIES (TOPOGRAPHIC)

2375 (11 SE
(DUMREAN)

5 III SW
ACHAM) 388

PENDLETON (U.S. 395) 28 MI.

25'

390


391

2 540 000 FEET

392

1188 22'30"

45°30'

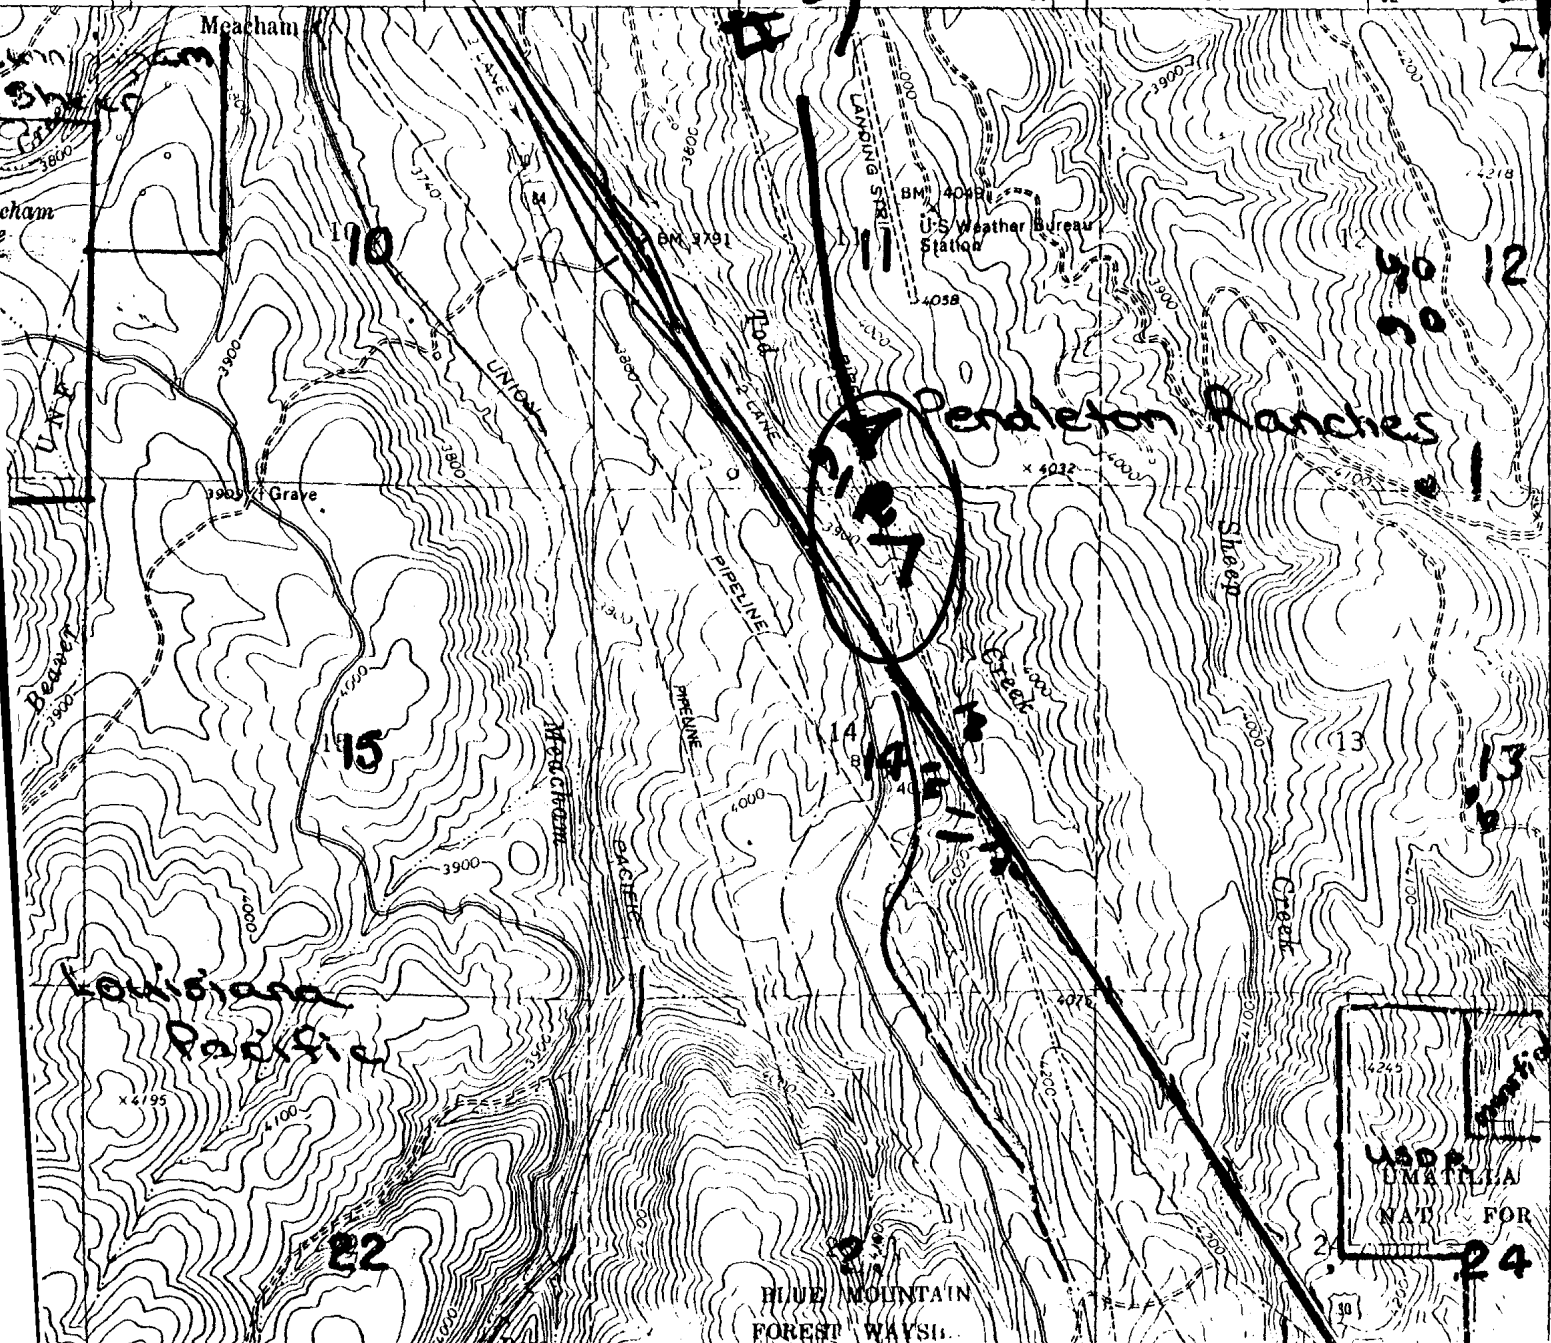

"CERTIFICATE NO.

Application No. 877212
Permit No.

WALDEN RESOURCES DEPT.
SALEM, OREGON

DEC 30 1994

RECEIVED



2375 III SE
(DUNN)

PENDLETON (U.S. 395) 28 MI

254

390

391 | 2 540 000 FEET

118°22'30"

 $-45^{\circ}30'$

5039

5038

670 000
—
FEET

5037

236

CERTIFICATE NO

5-

DEC 30 1994

WATER RESOURCES DEPT.
SALEM, OREGON

Application No. K-77212
Permit No. 15
RECEIVED

DEAD

Meachem
- LAKE
H3

UMATILLA
NAT FOR

24