

RECEIVED

DEC 30 1994

WATER RESOURCES DEPT.
SALEM, OREGON

Application No. R-77213
Permit No.

"CERTIFICATE NO. 10014"

DUNCAN

#2

T 1 S

680 000
FEET

2

45° 30'
118° 22' 30"

(MEACHAM LAKE)
2374 IV NW




Mapped, edited, and published by the Geological Survey

Control by USGS and NOS/NOAA

Topography by photogrammetric methods from aerial
photographs taken 1957. Field checked 1964

Polyconic projection. 1927 North American Datum

10 000-foot grid based on Oregon datum

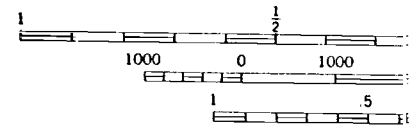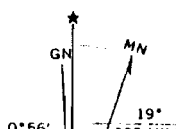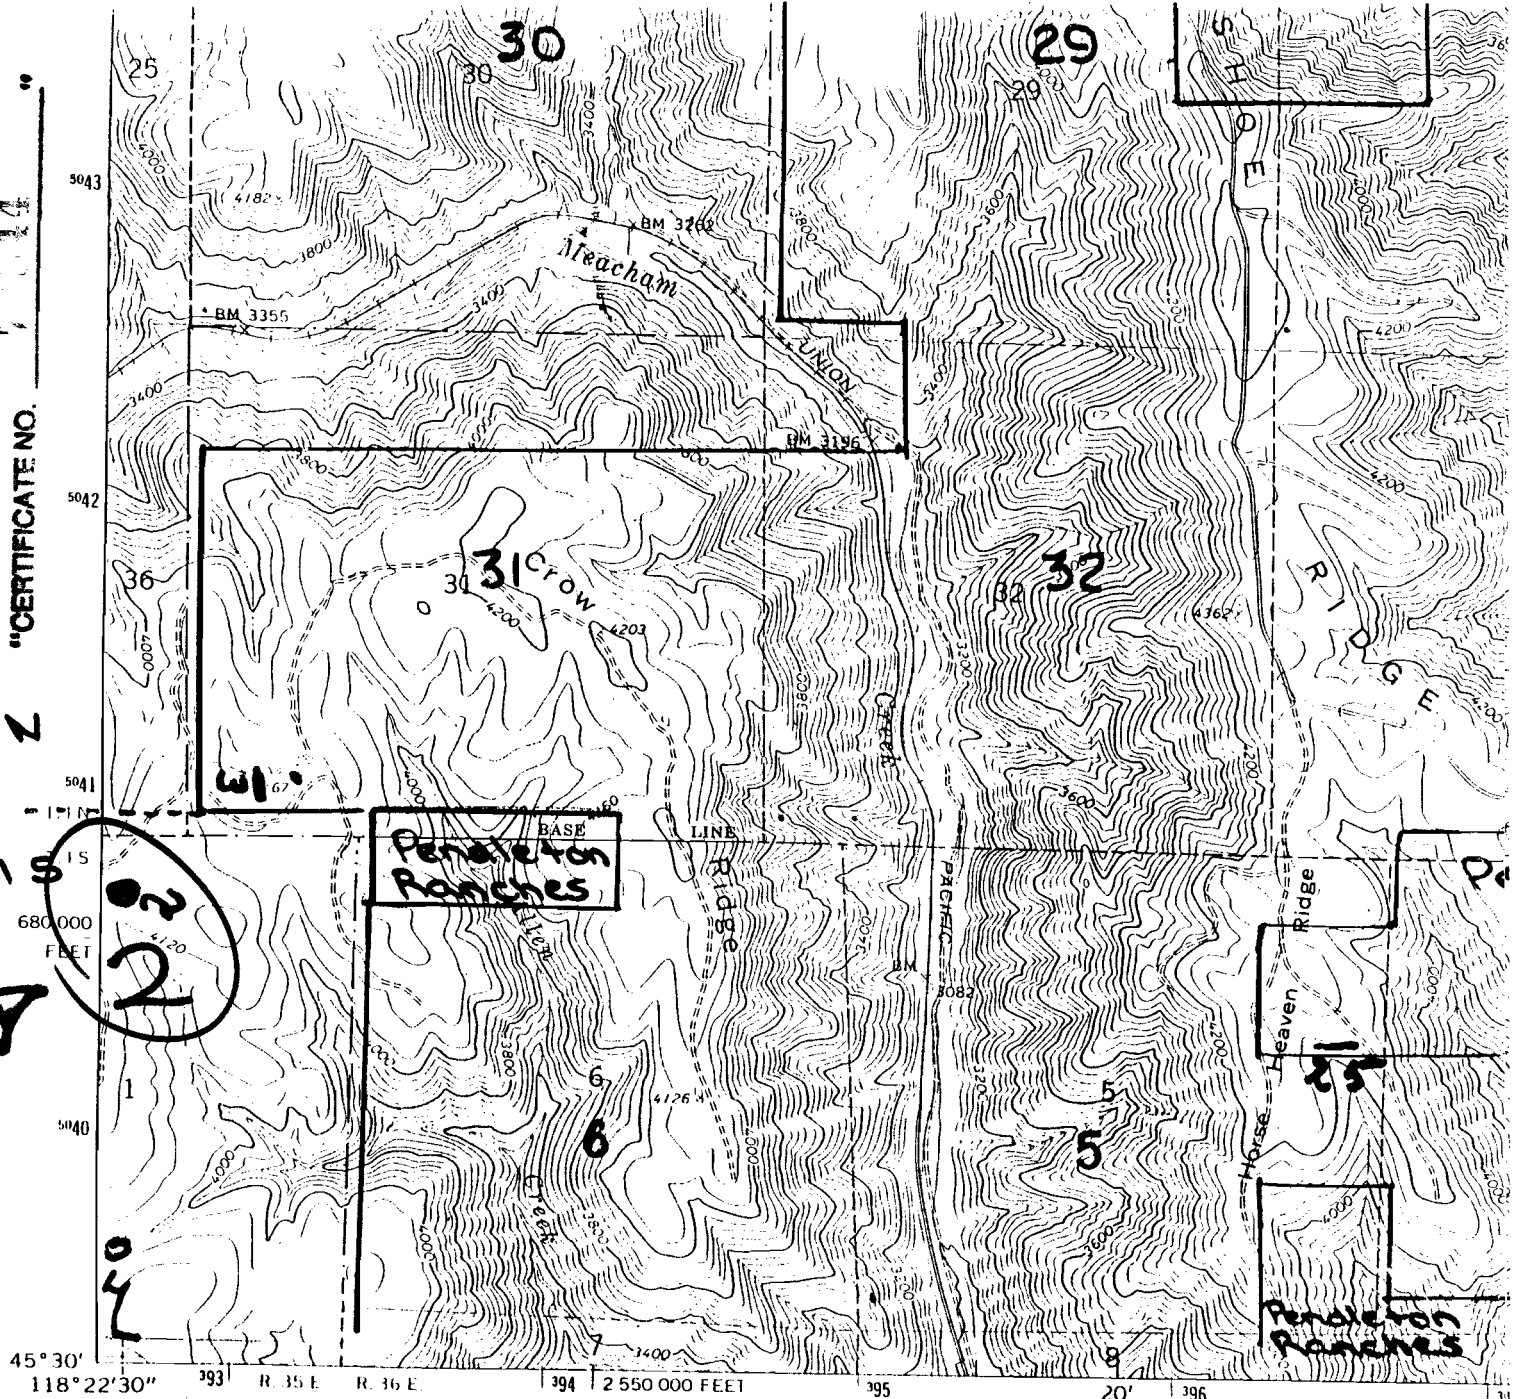

DEC 30 1994

WATER RESOURCES DEPT.
SALEM, OREGON

Application No. R-77213
Permit No.

"CERTIFICATE NO.

2



680 000
FEET

Mapped, edited, and published by the Geological Survey

Control by USGS and NOS/NOAA

Topography by photogrammetric methods from aerial
photographs taken 1957. Field checked 1964

Polyconic projection. 1927 North American Datum
10,000-foot grid based on Oregon coordinate system

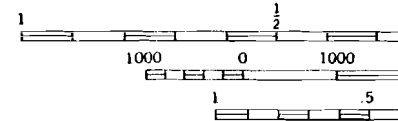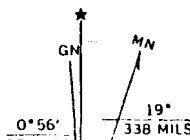

CON

RECEIVED

DEC 30 1994

UNITED STATES
DEPARTMENT OF THE INTERIOR
GEOLOGICAL SURVEY

WATER RESOURCES DEPT.
SALEM, OREGON


118°22'30" 45°30' 393 R. 35 E. 1 R. 36 E. 394000m.E.

HURON
7

Application No. R-77213
Permit No.

PERMIT NO.

1994

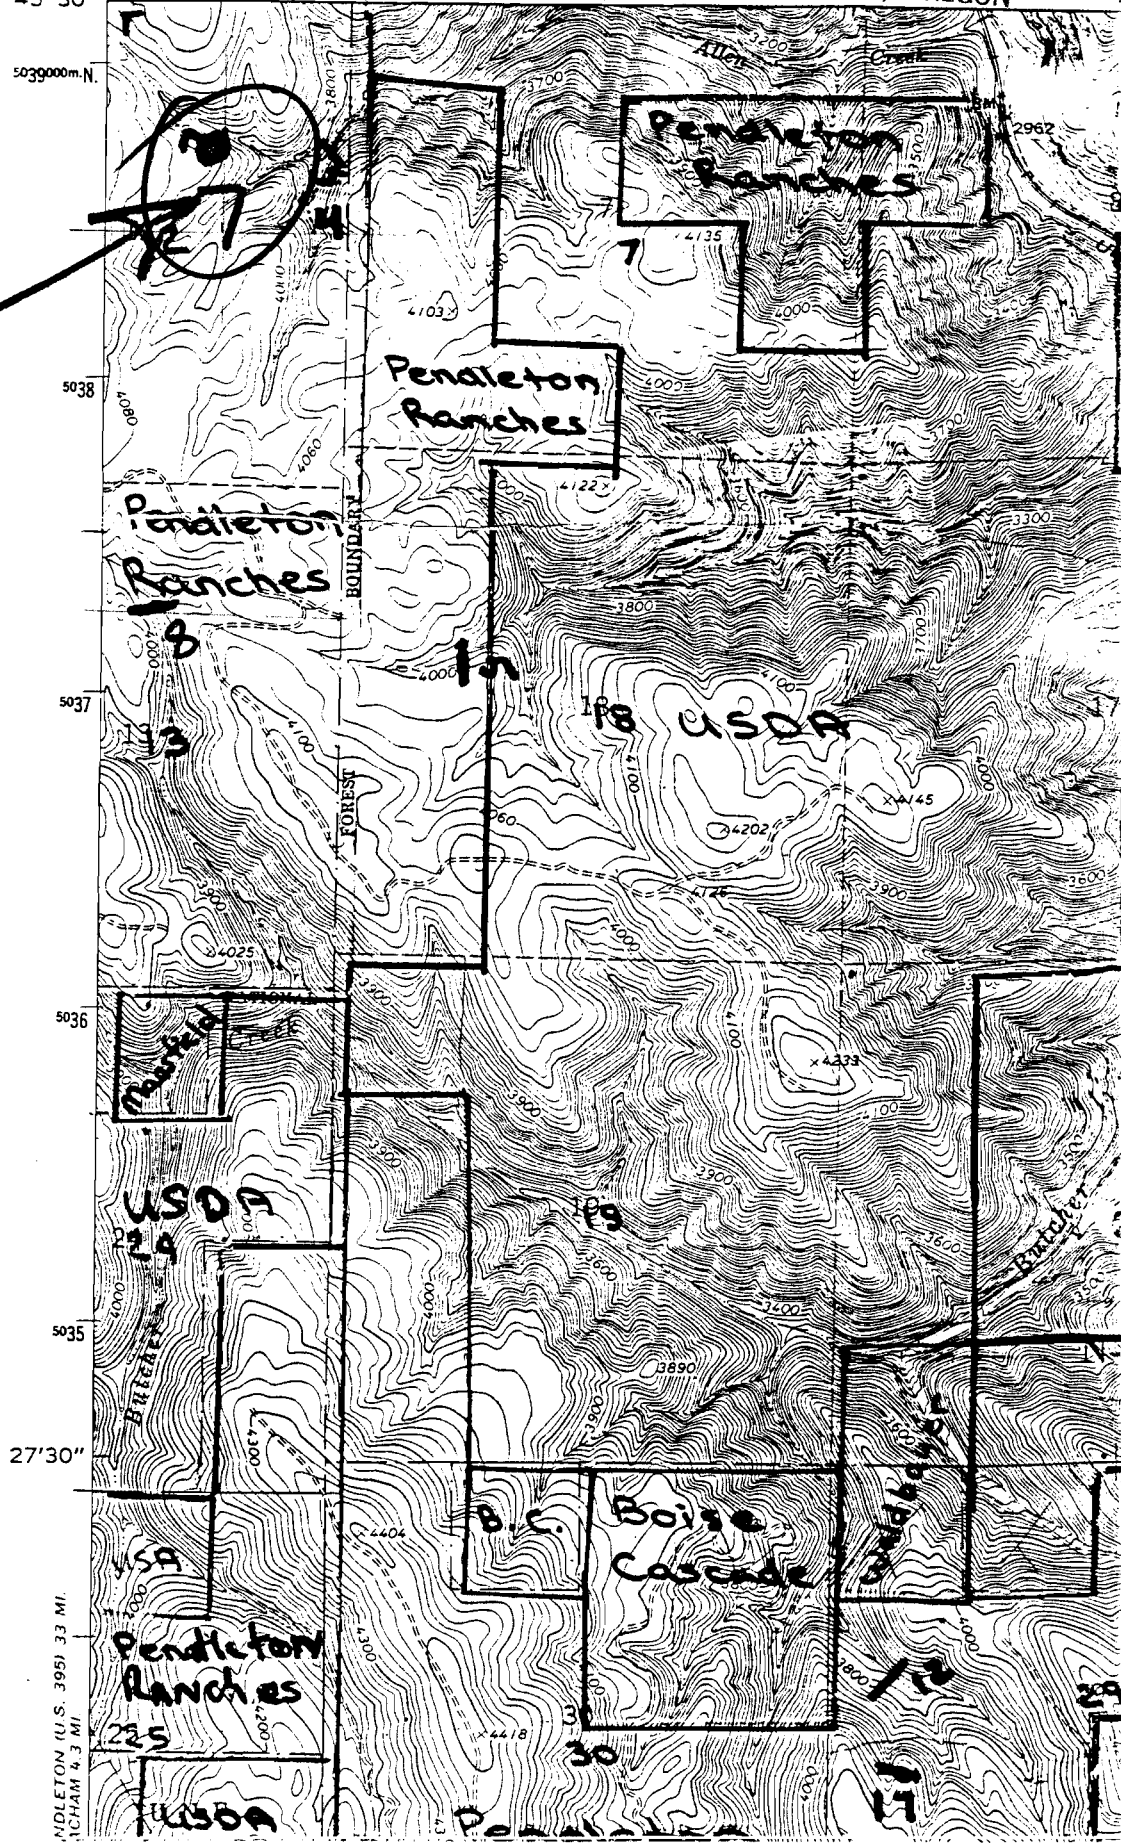

UNITED STATES
DEPARTMENT OF THE INTERIOR
GEOLOGICAL SURVEY

RECEIVED

DEC 30 1994

118°22'30" 393: R. 35 E. R. 36 E. 394000m. E.

45°30'

5039000m. N.

5038

5036

5035

27'30"

ADLETON (U.S. 395) 33 MI.
CHAM 4.3 MI

WATER RESOURCES DEPT
SALEM, OREGON

Pendleton
Ranches

Pendleton
Ranches

Pendleton
Ranches

USDA

USDA

B.C. Boise
Cascades

Pendleton
Ranches

USDA

Huron
#8

Application No. R-77219
Permit No.

DATE NO.

1994

2315-111 SW
(MEADHAM)

Boise
Cascades
Weber

BM 2247

Spring

USA

Duncan

USDA

21

8 3425

USDA

17

USDA

USA

USDA

USDA

20

7

Little
Squaw Spring

18

Pendleton
Ranch

Smith
Gate

19

Pendleton
Ranch

2375 III SW
(MEACHAM)

24 Creek

32'30"

RECEIVED

DEC 30 1994

WATER RESOURCES DEPT.
SALEM, OREGON

DUNCAN
#27

"CERTIFICATE NO.

77213

Application No. 8-77213

Permit No.

RECEIVED

DEC 30 1994

WATER RESOURCES DEPT.
SALEM, OREGON

FIG 14


CERTIFICATE NO.

Application No. K-77213

Permit No.

2375 III SW

Duncan
#28

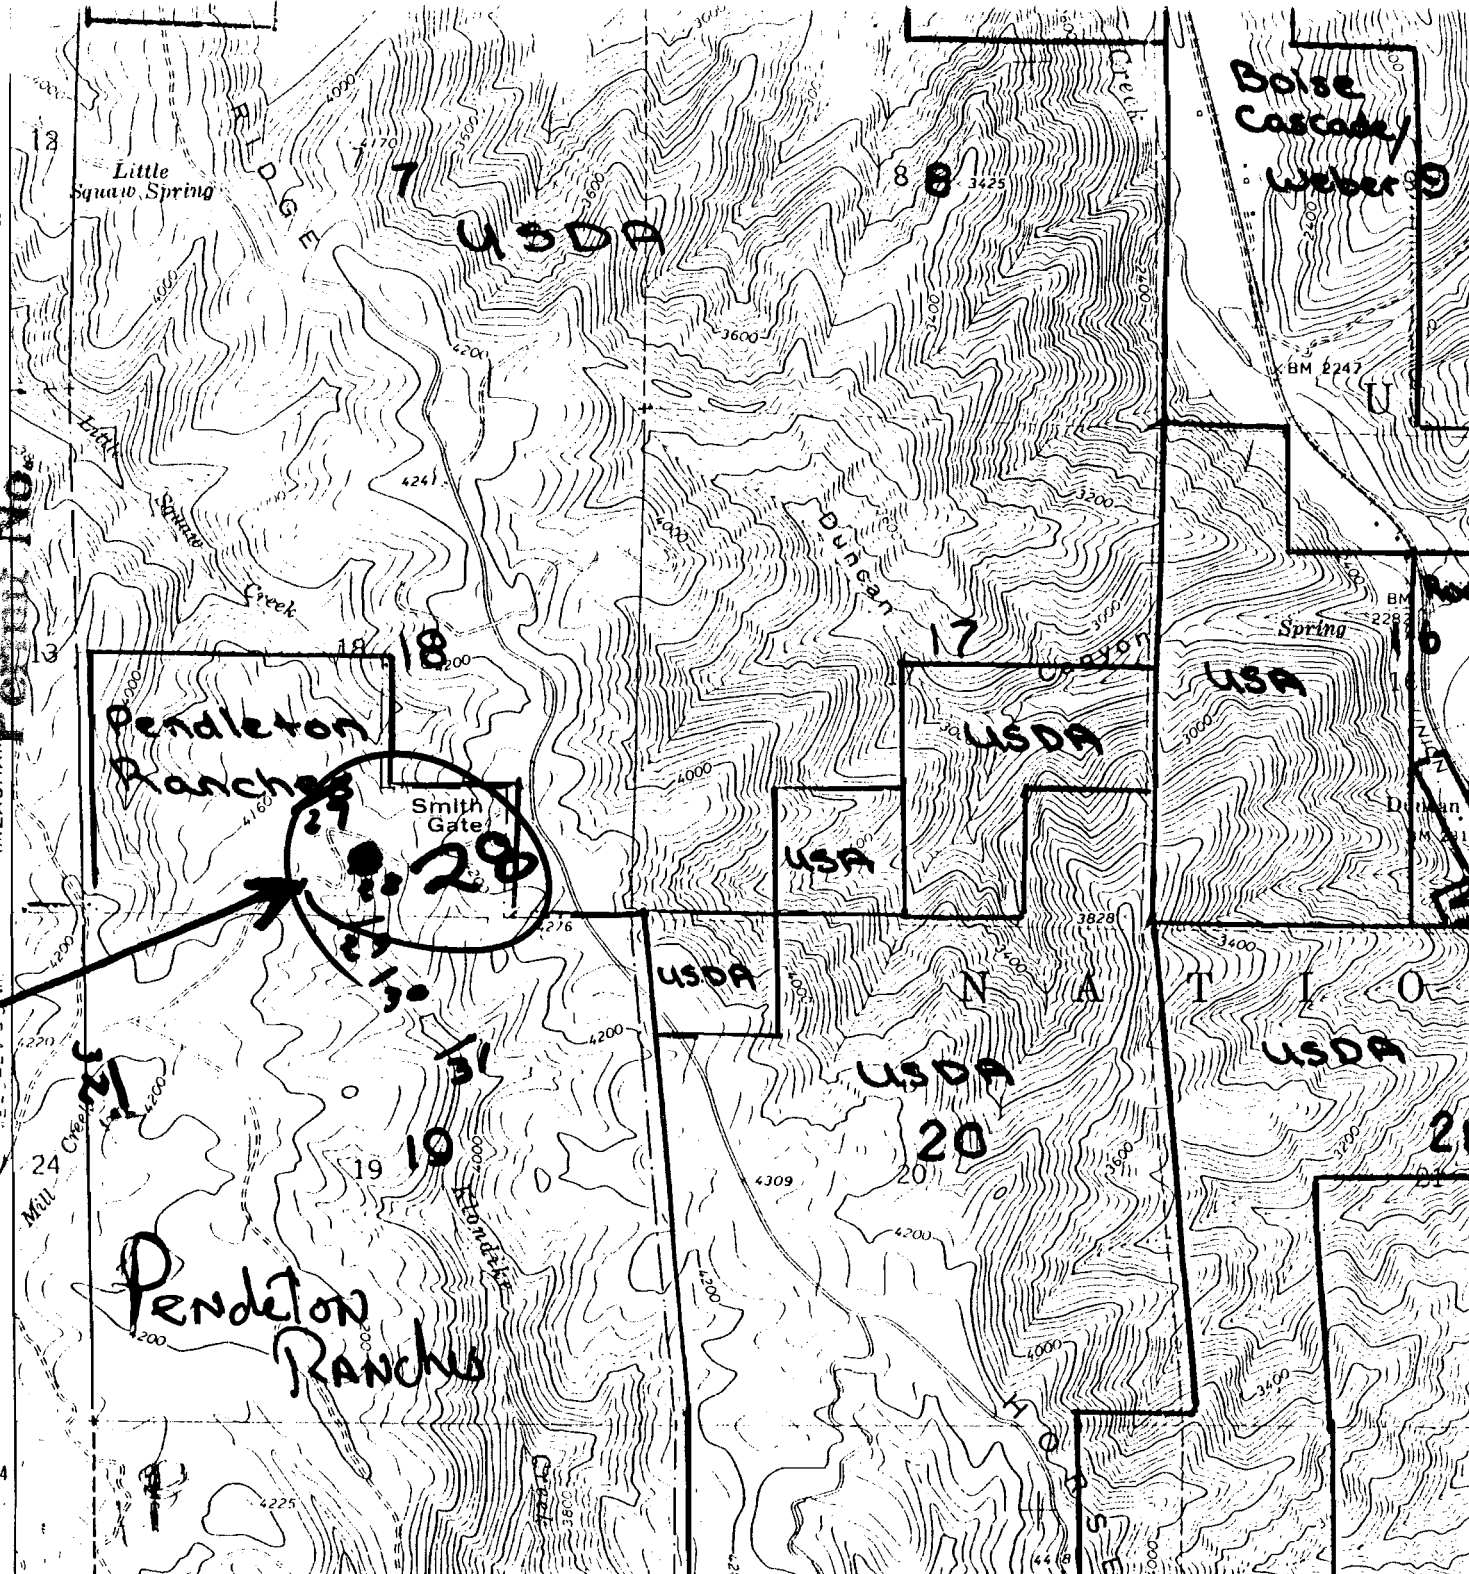

5044
32'30"

RECEIVED

DEC 30 1994

WATER RESOURCES DEPT.
SALEM, OREGON

*CERTIFICATE NO. 14

Application No. R-77213

Permit No.

29



Pendleton Ranches

Smith Gate

Pendleton Ranches

USDA

USDA

USDA

USDA

USDA

20

USA

USDA

21

Boise
Cascade
Weber

BM 2247

Spring

Duncan

2375 III SW
(MEACHAM)

VEACHAM - SW

5044

32'30"

5048

5047

BM 2282

BM 2310

4468

4225

4309

3828

31

10

19

18

18

13

13

8

7

18

Little
Square Spring

Little
Square
Creek

Duncan



































RECEIVED

DEC 30 1994

WATER RESOURCES DEPT.
SALEM, OREGON


DUNCAN
31

CERTIFICATE NO. 1001A

Application No R-77213
Permit No.

23751 S.W. (MEACHAM)

5044
32' 30"

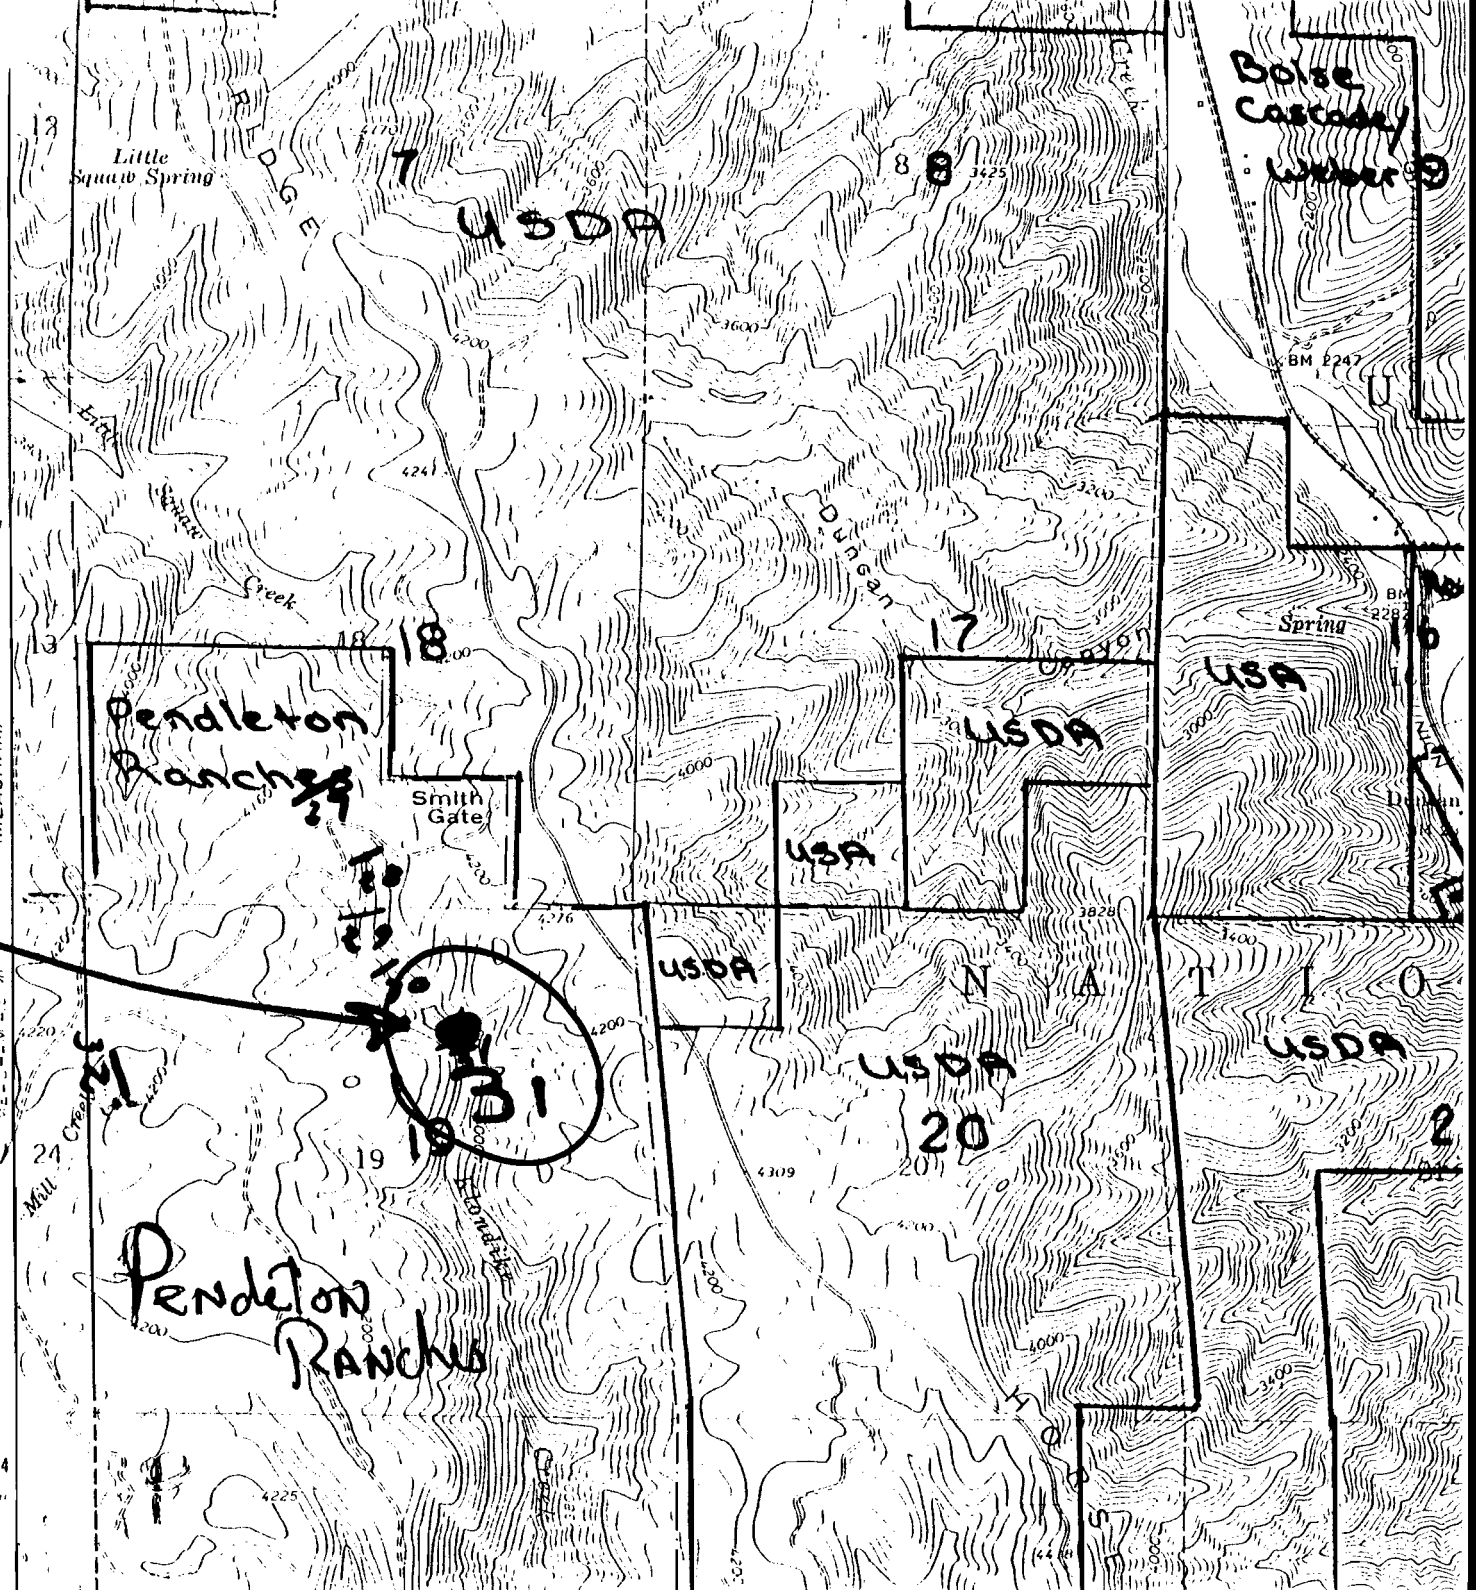

RECEIVED

DEC 30 1994

WATER RESOURCES DEPT.
SALEM, OREGON

1001A

APPENDIX NO.

Application No. R-77213
Permit No.

2375 III SW
(MEACHAM)

5044
32'30"

Duncan

#32

