


MAP of WATER FILING by HUGH I NOLAN
of GRANDVIEW OREGON
Tp 13 S, R9 11 E of W.M. Scale 1"=400'

Scale 1" = 400'

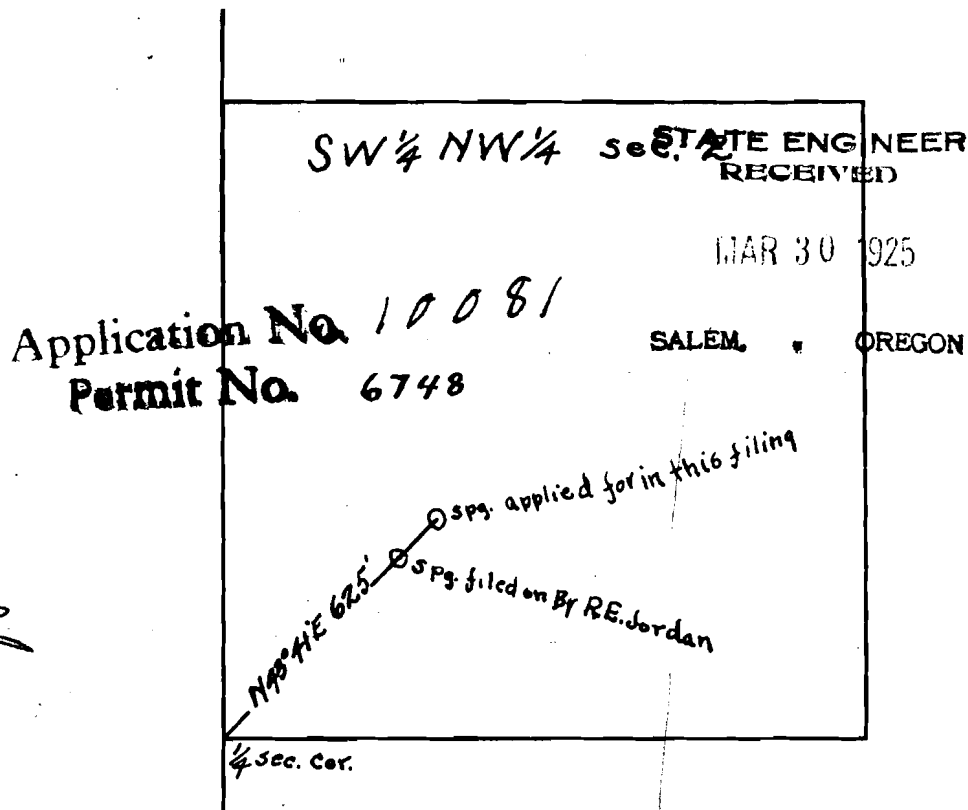

I, Raymond G Heider of Madras Oregon, do hereby certify that this map was made from notes taken during an actual survey made by me on March 26, 1925 and that it correctly represents the works described in the accompanying application together with the location of streams and other ditches in the immediate vicinity

Raymond G. Heider
County Surveyor

C-7507

1748