


8. 29587

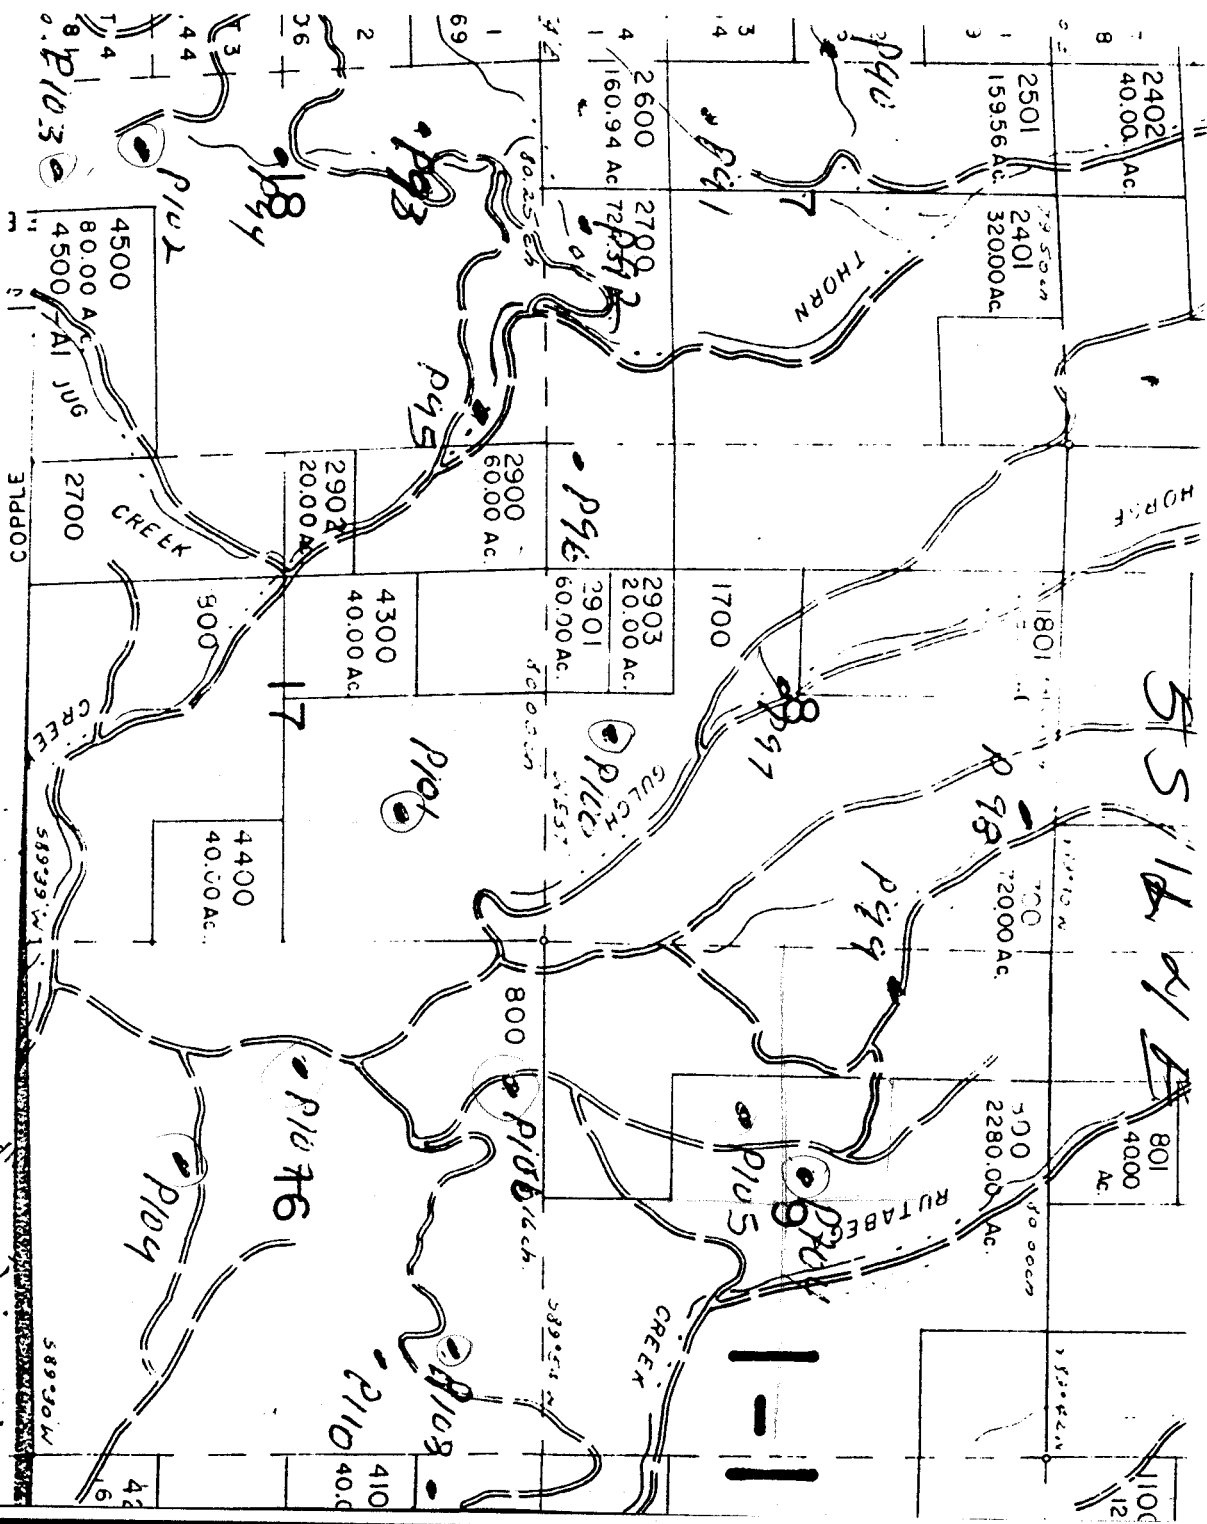

WATER RESISTANT
JAN - 4 1961
SALEM, OREGON