MORROW
4S 26

CANCELLED NOS
300
1901
2000
601
1600
1700
3100
3300
1400
1800
2300
2201
1501
2900
2901

PARCEL 1502

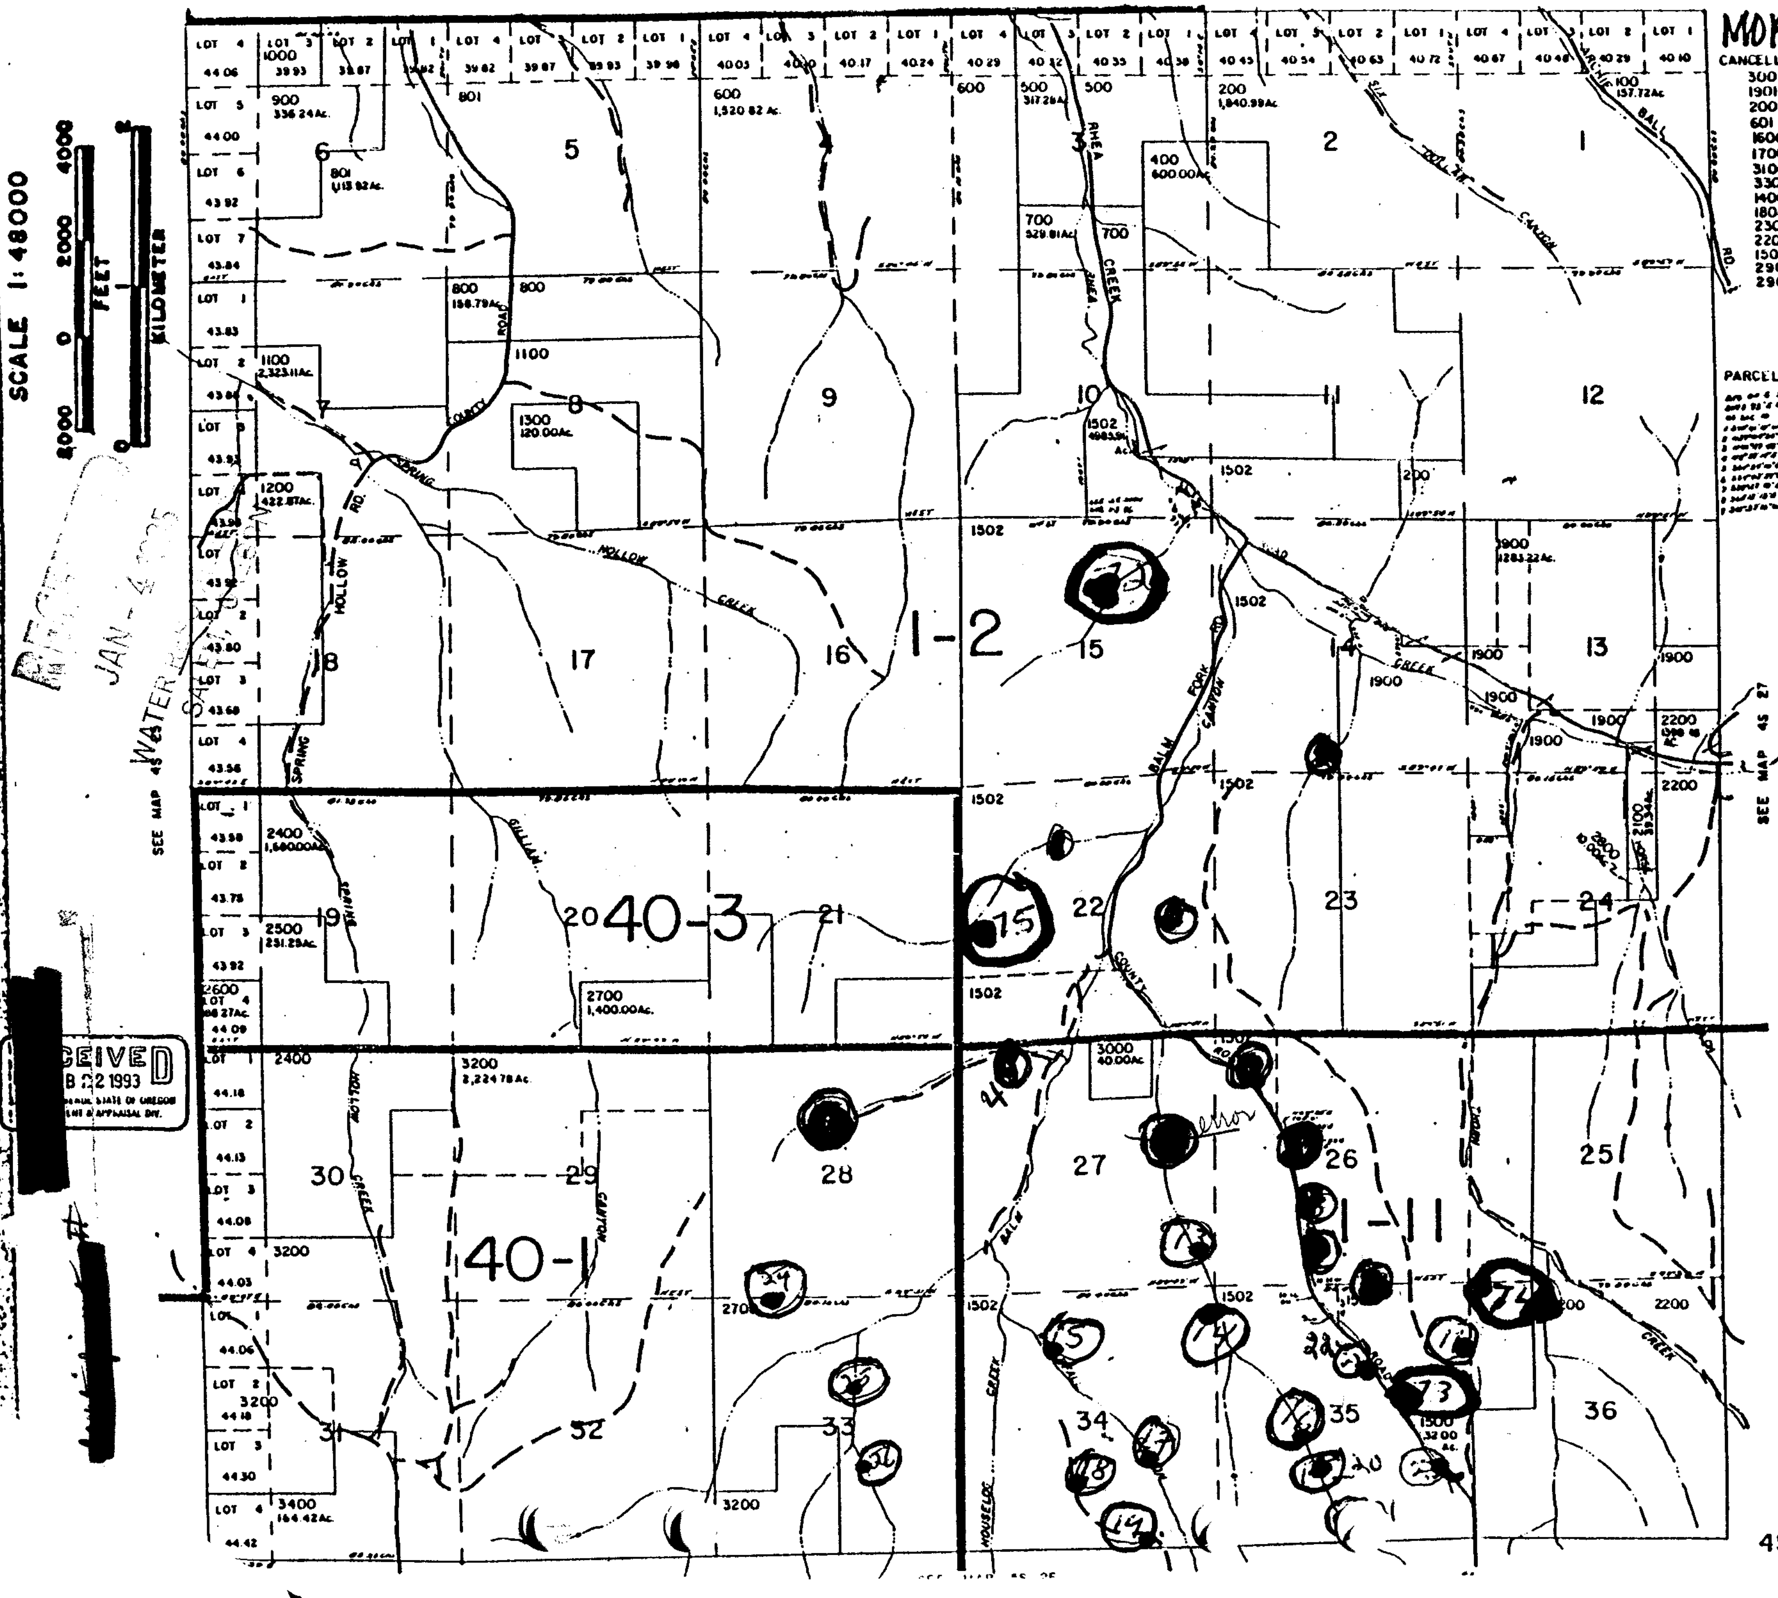

RECEIVED
JAN 4 1995
WATER RESOURCES DEPT.
SALEM, OREGON

[redacted]
RECEIVED
FEB 22 1993
WATER RESOURCES STATE OF OREGON
...ENT & APPRAISAL DIV.

[redacted]

Application No. R 79900
Cert # 71670