


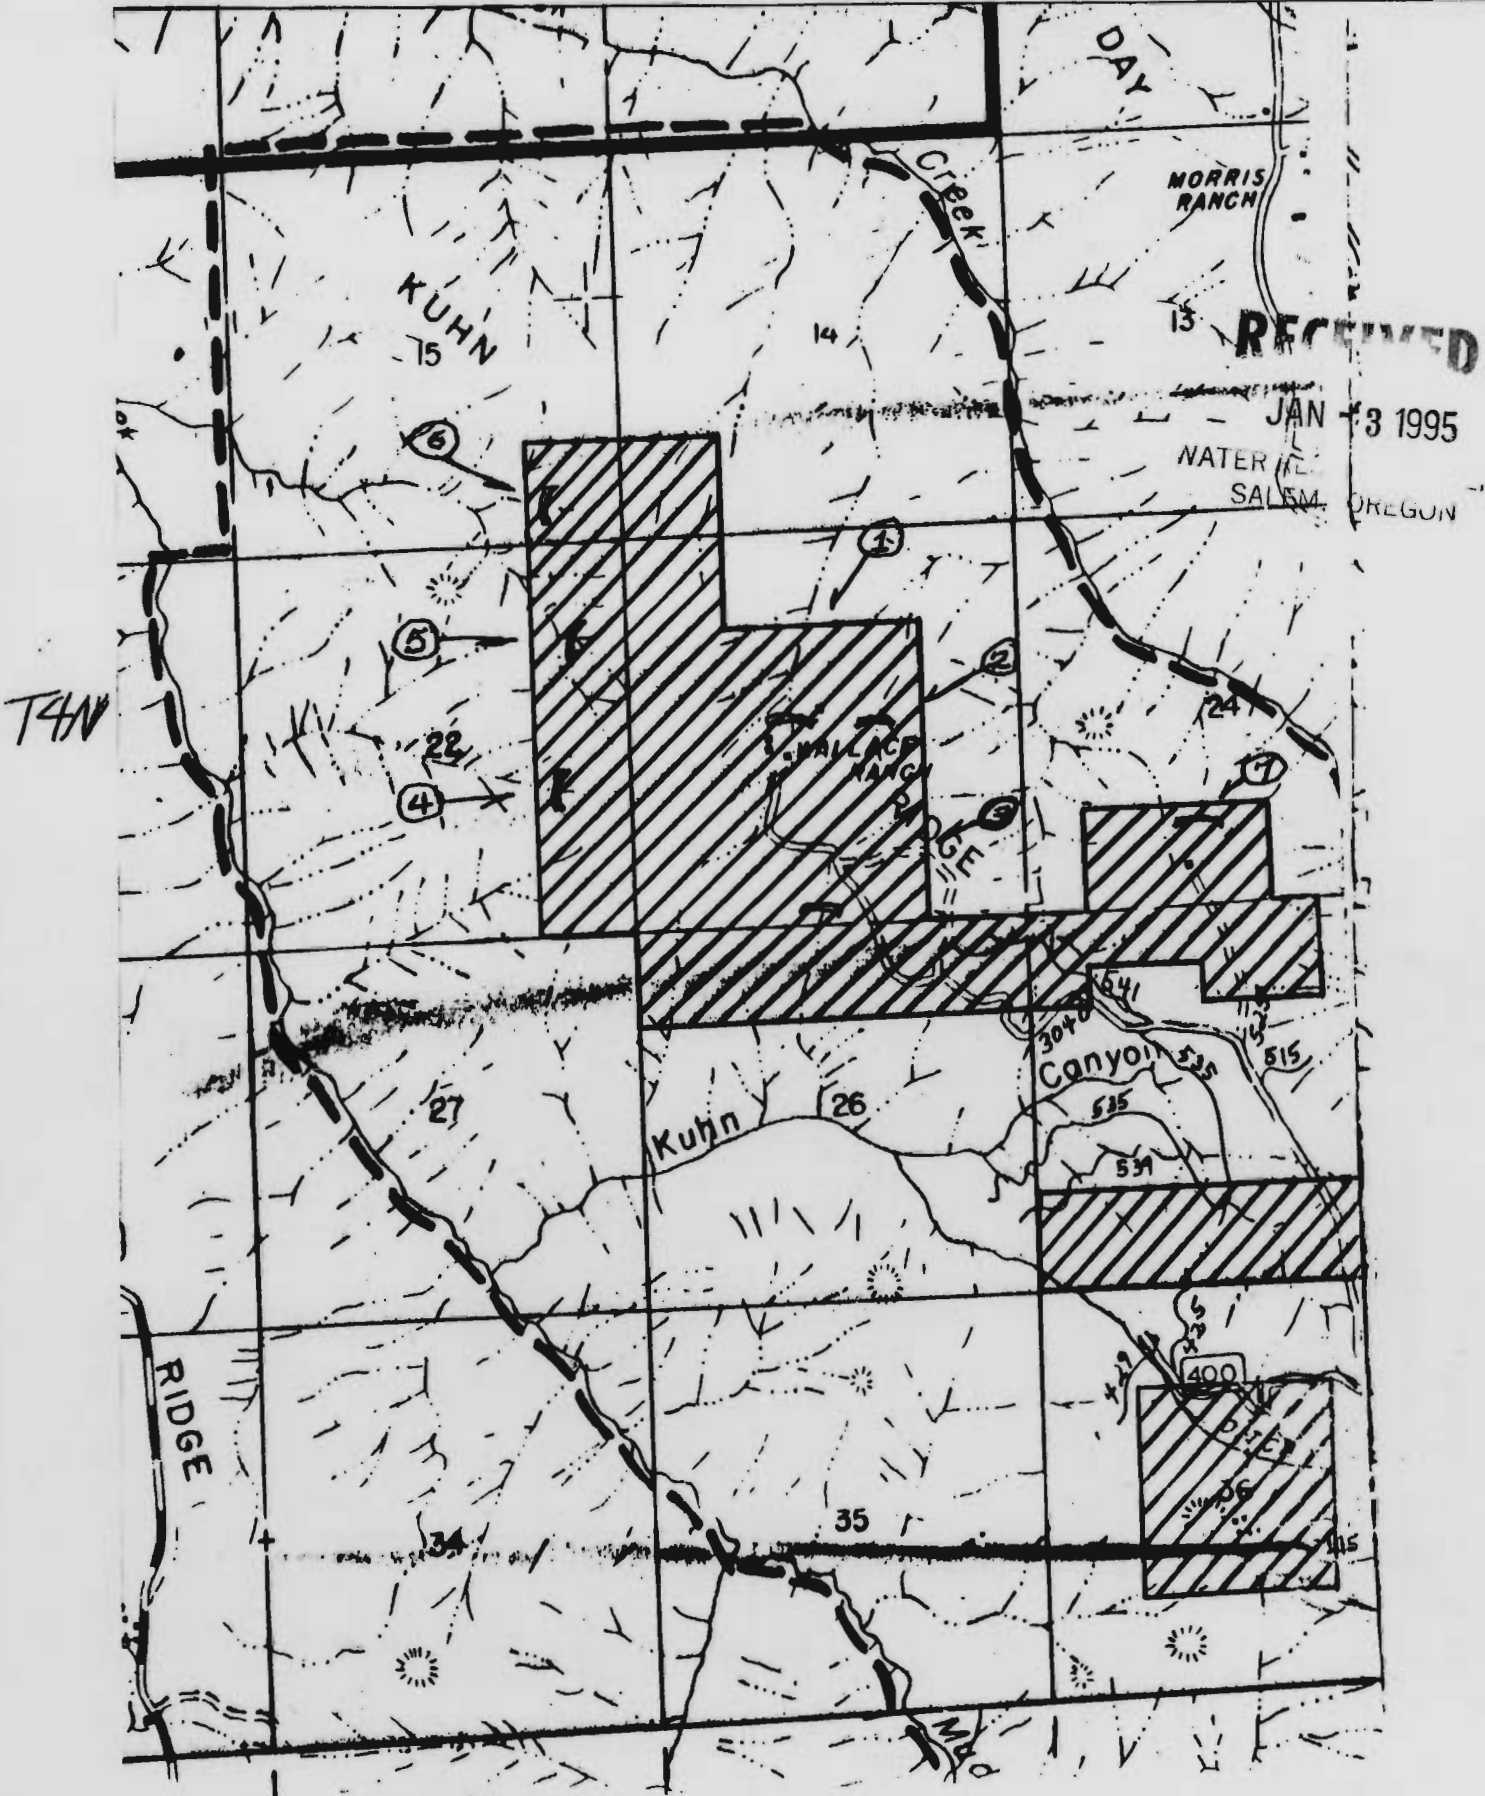

"CERTIFICATE NO. 71863 "R43E

Application No. R-80277

Permit No.