


Pond "A"

DEC 29 1994

WATER SALEM, OREGON

CERTIFICATE NO. 72022

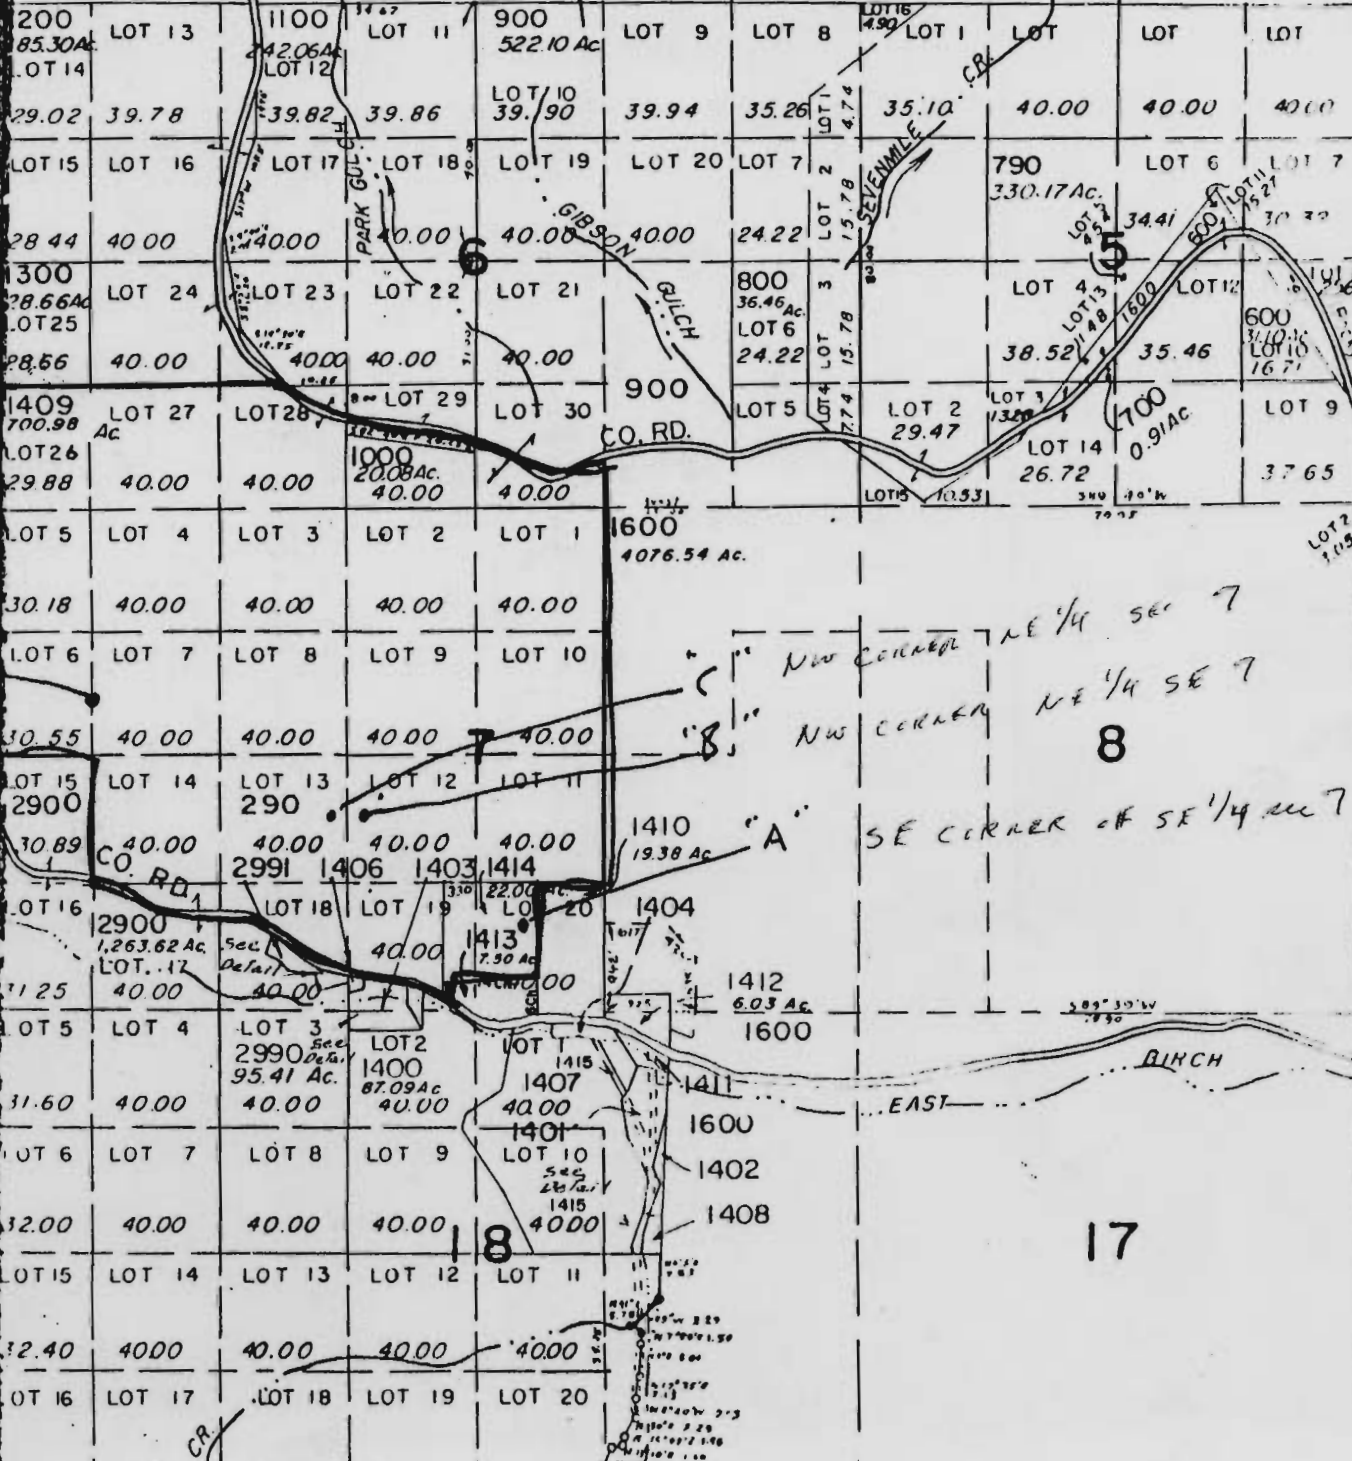

Sw corner
New 1/4 sec 7

NE 1/4 sec 7
NW corner
NE 1/4 SE 7
SE corner of SE 1/4 sec 7

MAP 2S 32

CR