


RECEIVED

JUL 23 1996

WATER RESOURCES DEPT.
SALEM, OREGON

RECEIVED
JAN 30 1993
U.S. DEPARTMENT OF AGRICULTURE

SCALE 1"=5000'
0 2000 4000
FEET
KILOMETER

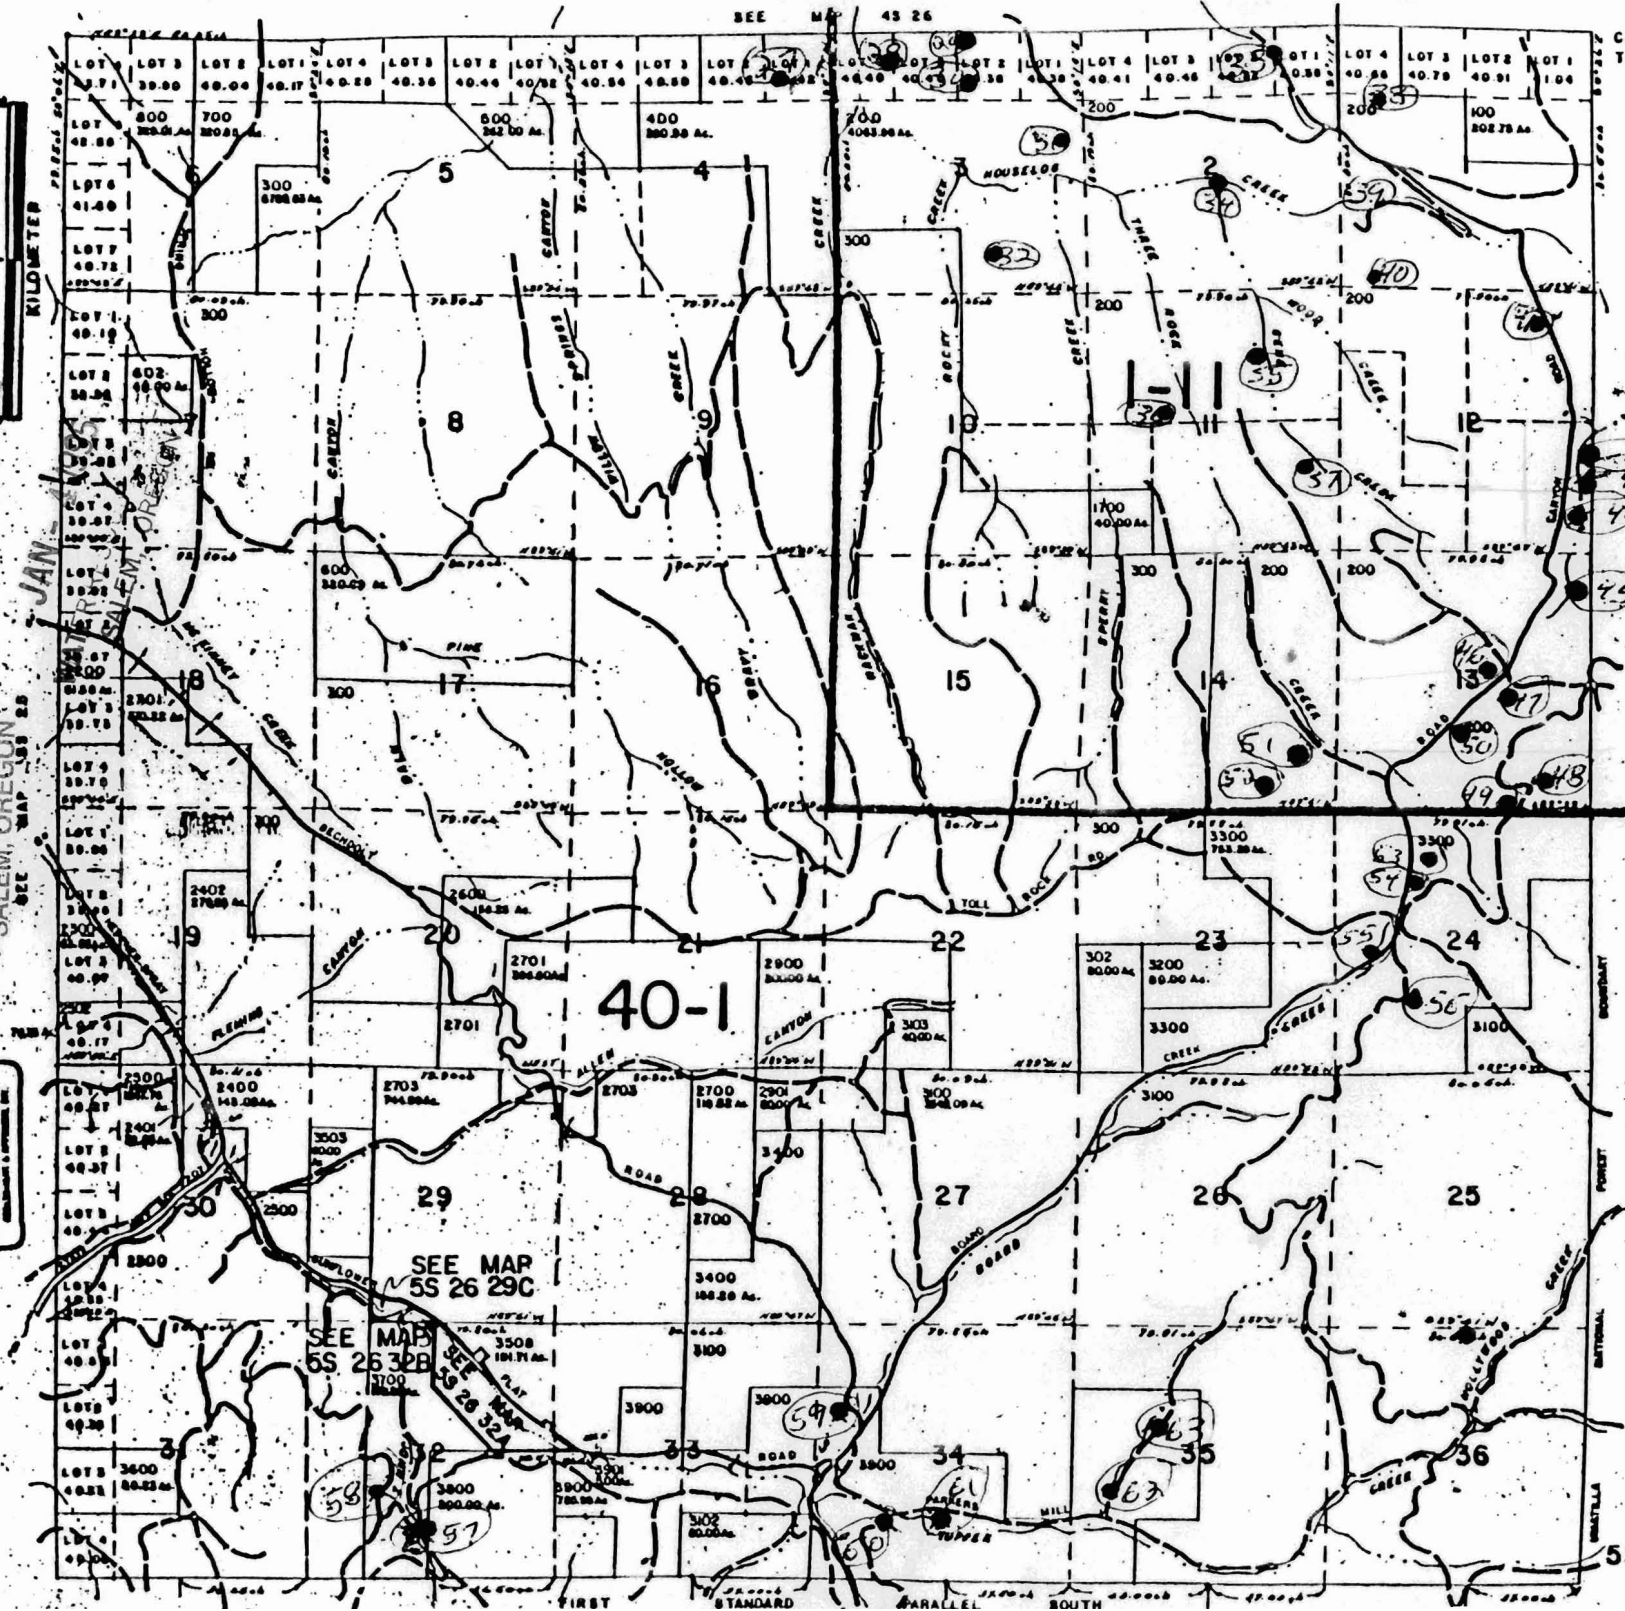

CANCELLED NOS.
T.L. 601
900 thru 55 26
1400
1800 thru
2100
2702
2800
3000
3500 thru
3503
3505 thru
3507
3701 thru
3703
3504A1
3504A2
3504A3
3504A4
3504A5
3504A6
3704
1800
1804
3504
2801
501
501
201
1500
3101
3301
4008
2508

55 26 B
INDEX