


SEE MAP 2S 28

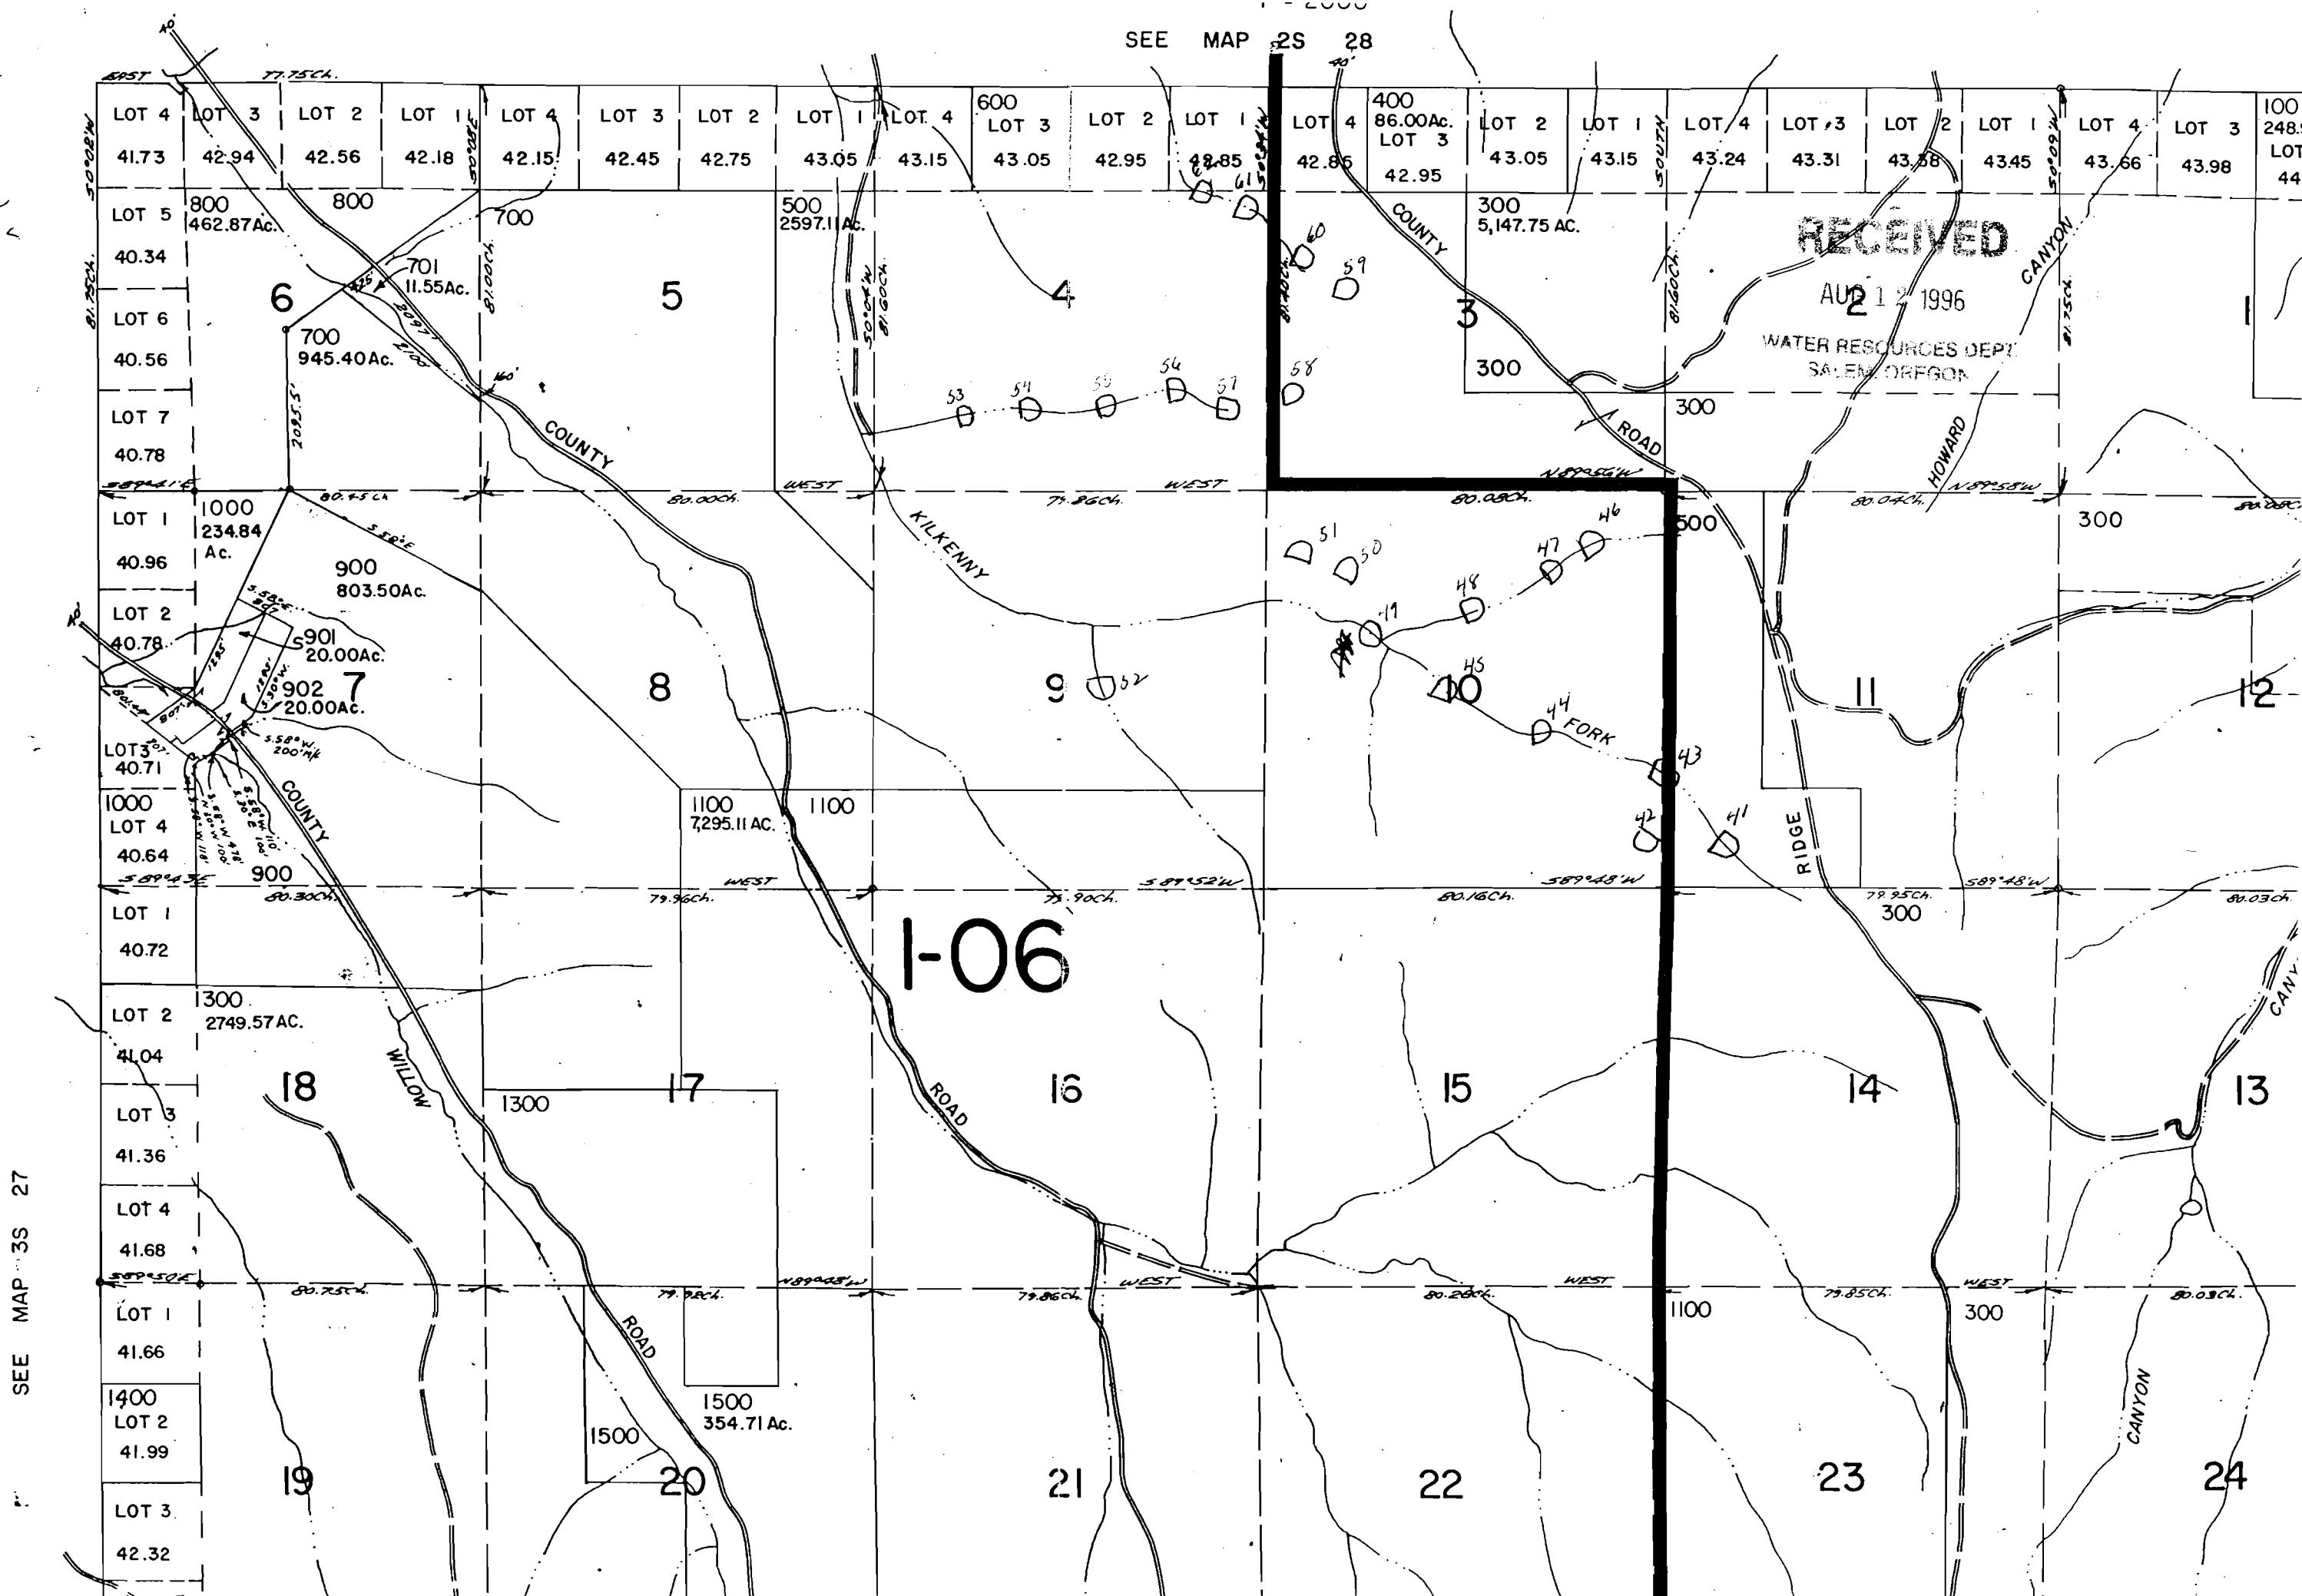

SEE MAP 3S 27

No Final Proof Map available

No Permit Map available