

VED
1992
OF OREGON
FIREARMS DIV.

LOT 4
40.10

31

20

S89 • 42W

TROUT

CREEK

29

3800
120.00 AC.

32


2600 21 2600
76.00 AC.

28

3300
40.00 AC.

389° 45' W 80.20 CH.

33

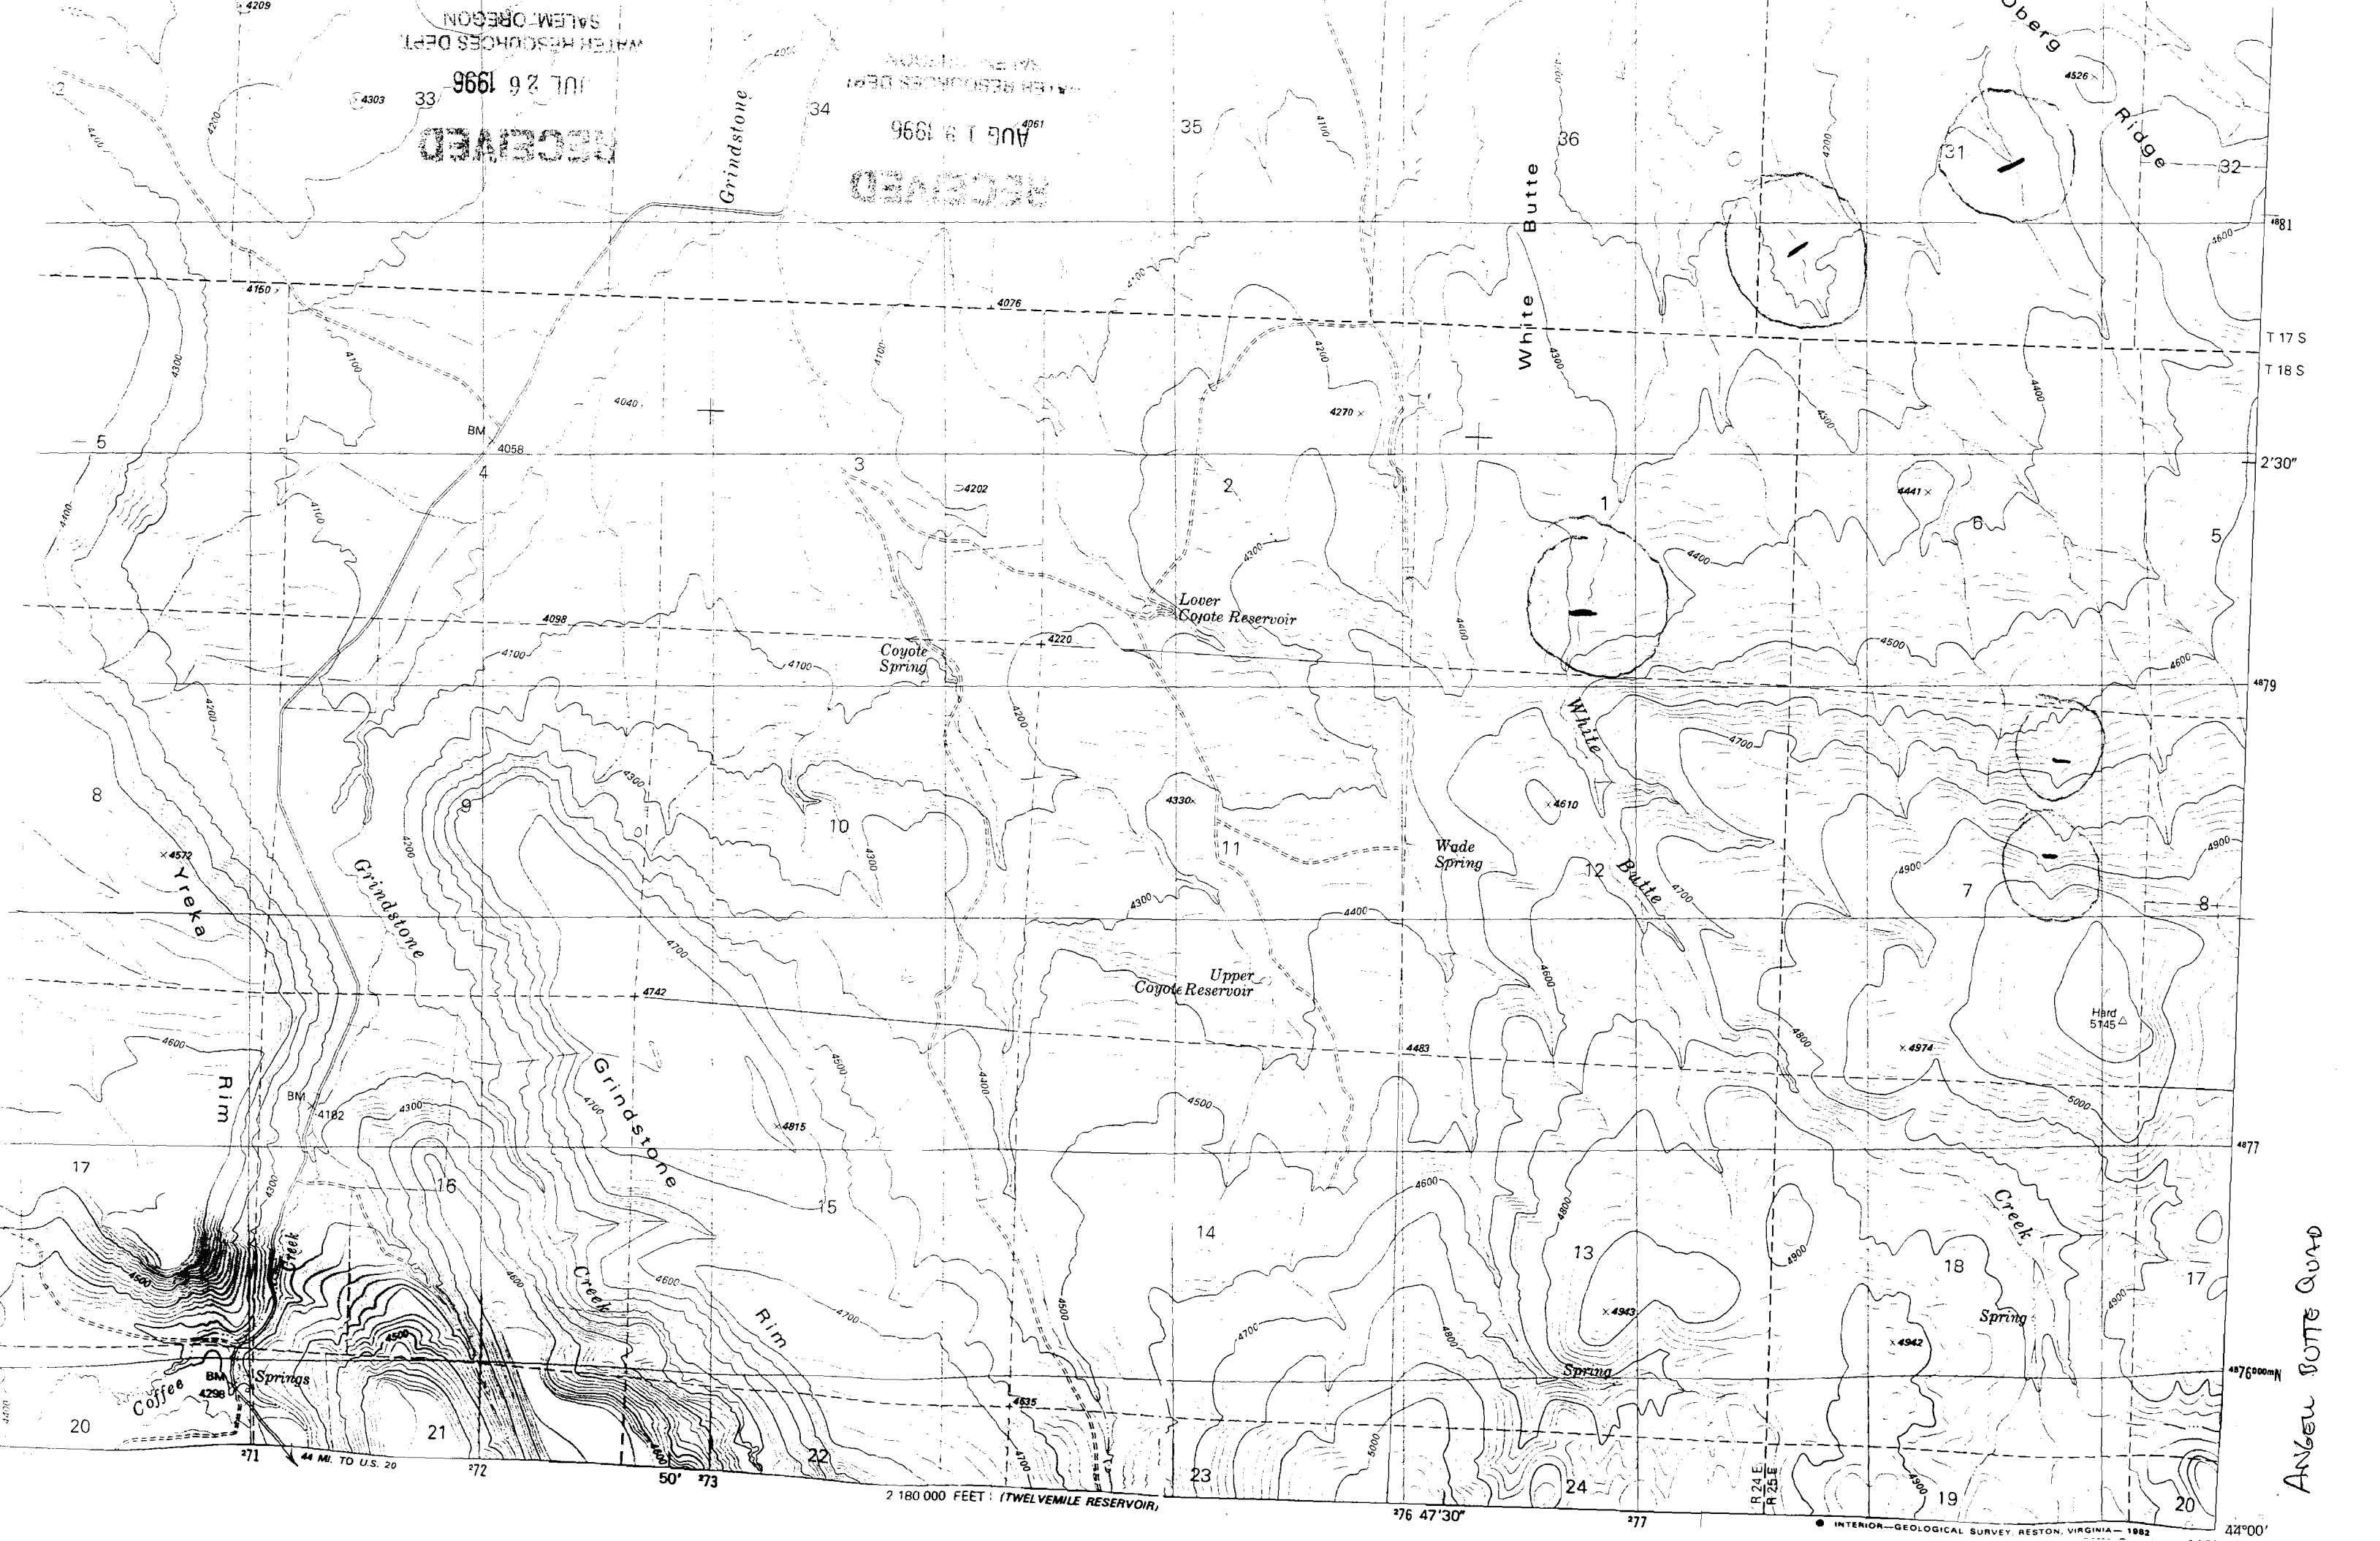

RECEIVED
JUL 26 1996
WATER RESOURCES DEPT.
SALEM OREGON

RECEIVED
AUG 1 1996
WATER RESOURCES DEPT.
SALEM OREGON

ANGEW BUTTE QUAD