

Application No. R-81579
 Permit No.

SEC MAP 35 27


3528E

RECEIVED
 DEC 30 1994

WATER RES.


Order #:
 1, 18, 19, 20, 21,
 2, 23, 24, 31, 32,
 33, 34, 35, 36,
 38, 39, 40, 41,
 43, 44, 45,
 48, 49, 50, 51,
 53

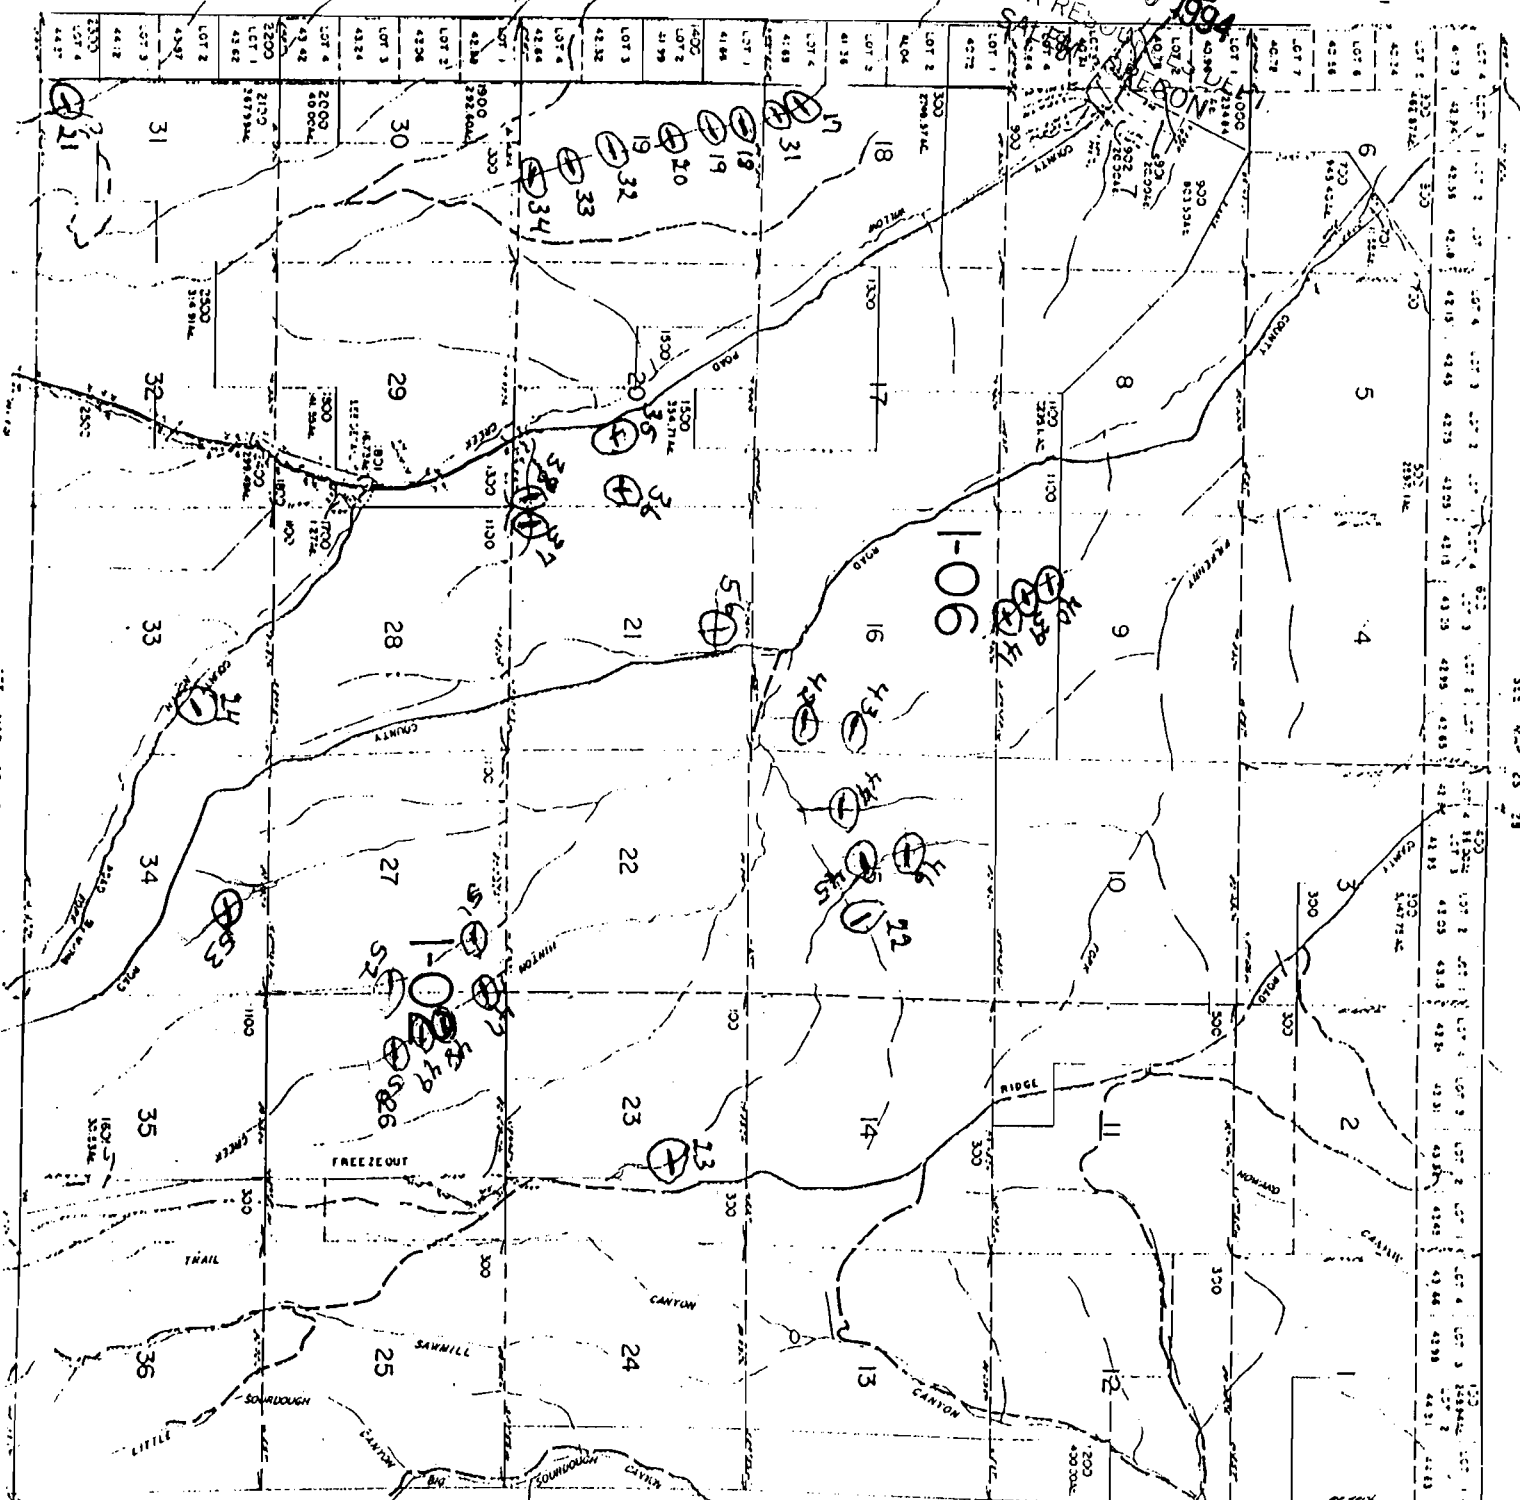

SEE MAP 35 29

CANCELLED
 NUMBERS
 200
 1800
 1300
 1100
 1302

35 28