


Ponds #
7, 8, 10, 12, 14, 15, 16, 28, 29,
30, 54, 55

3527E

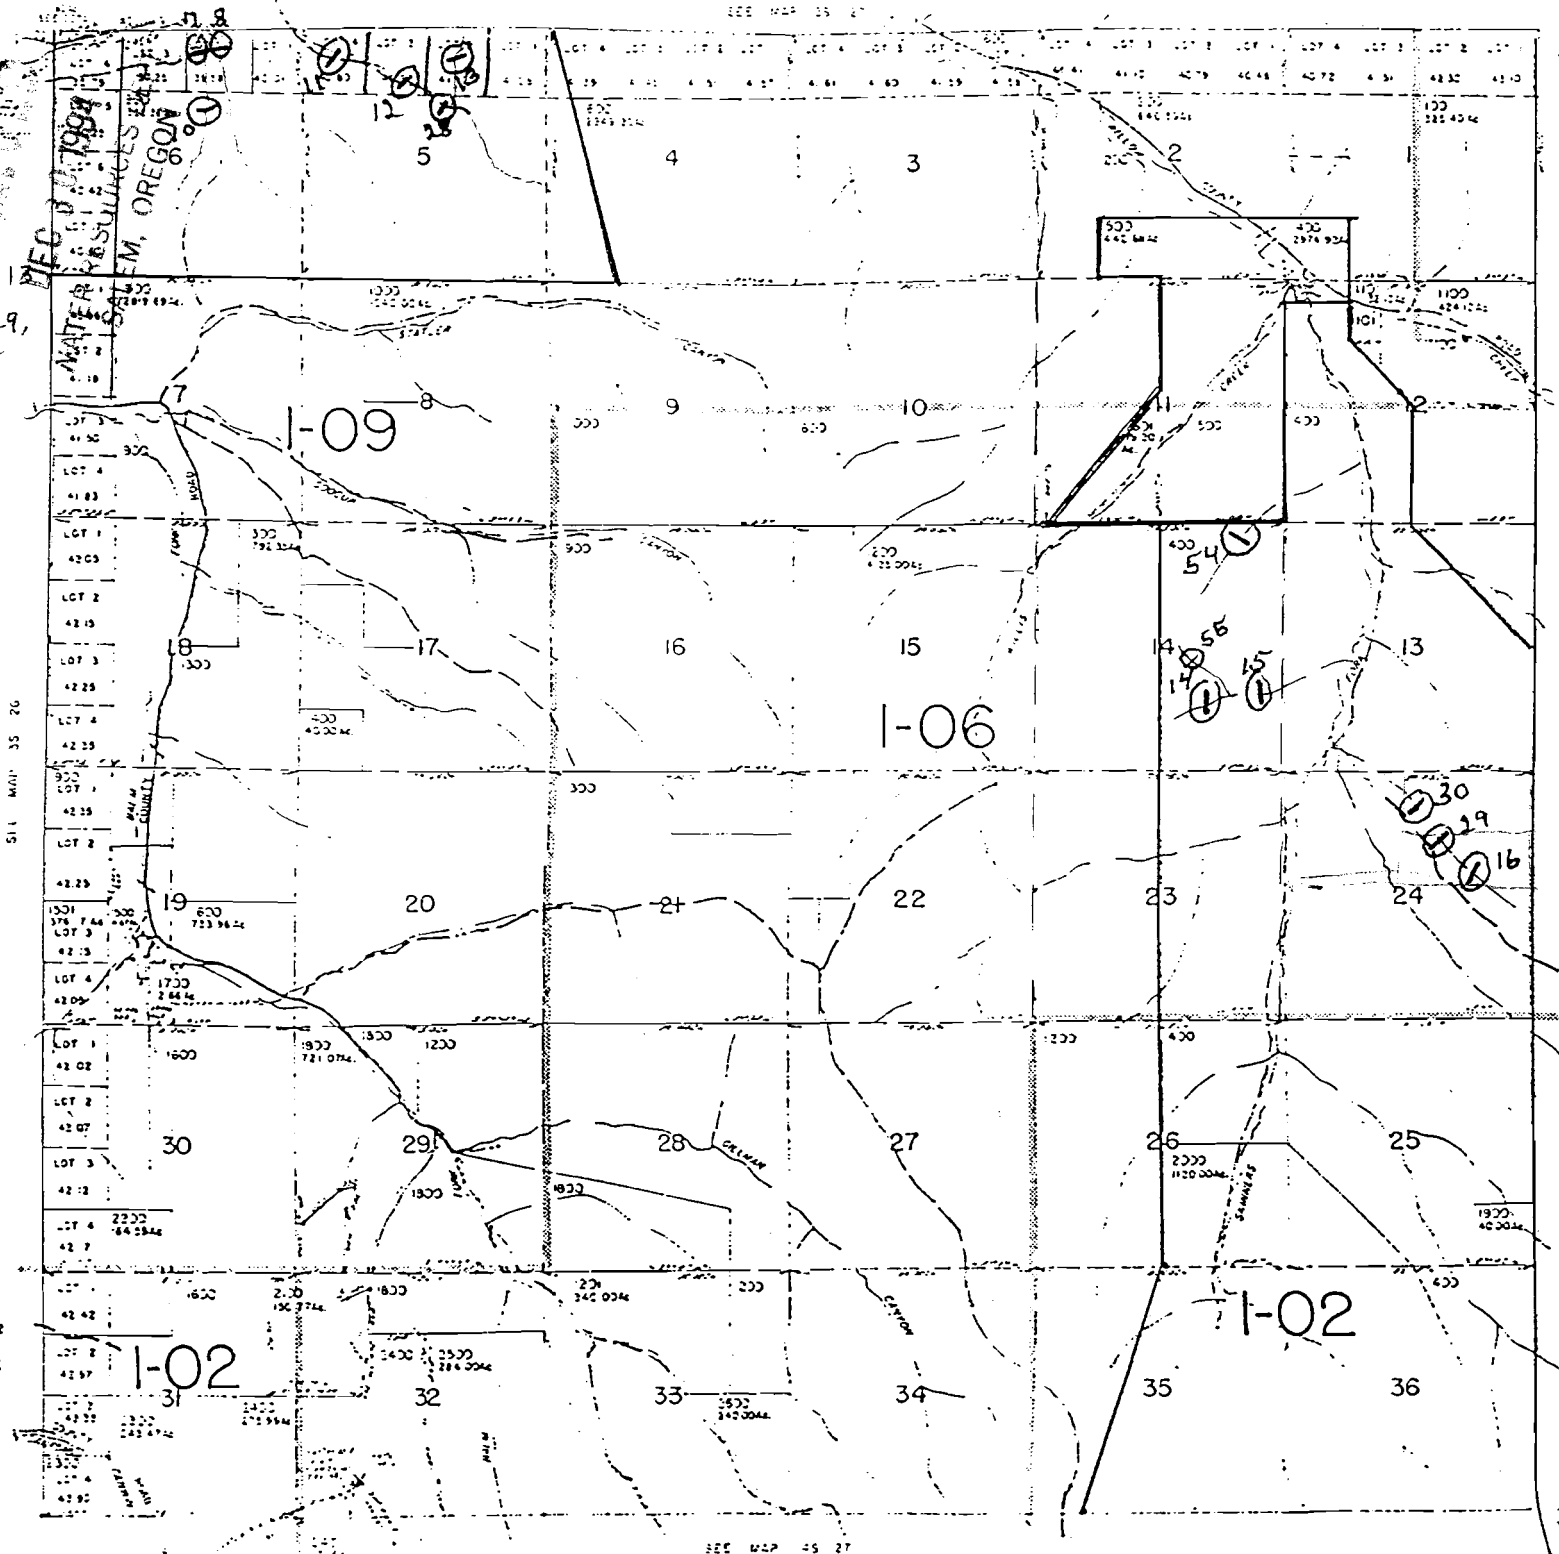

PARCELS 1000
T. 35 N.
R. 27 E.
S. 35
350

18518 P. 81581

