


35 27

3528E

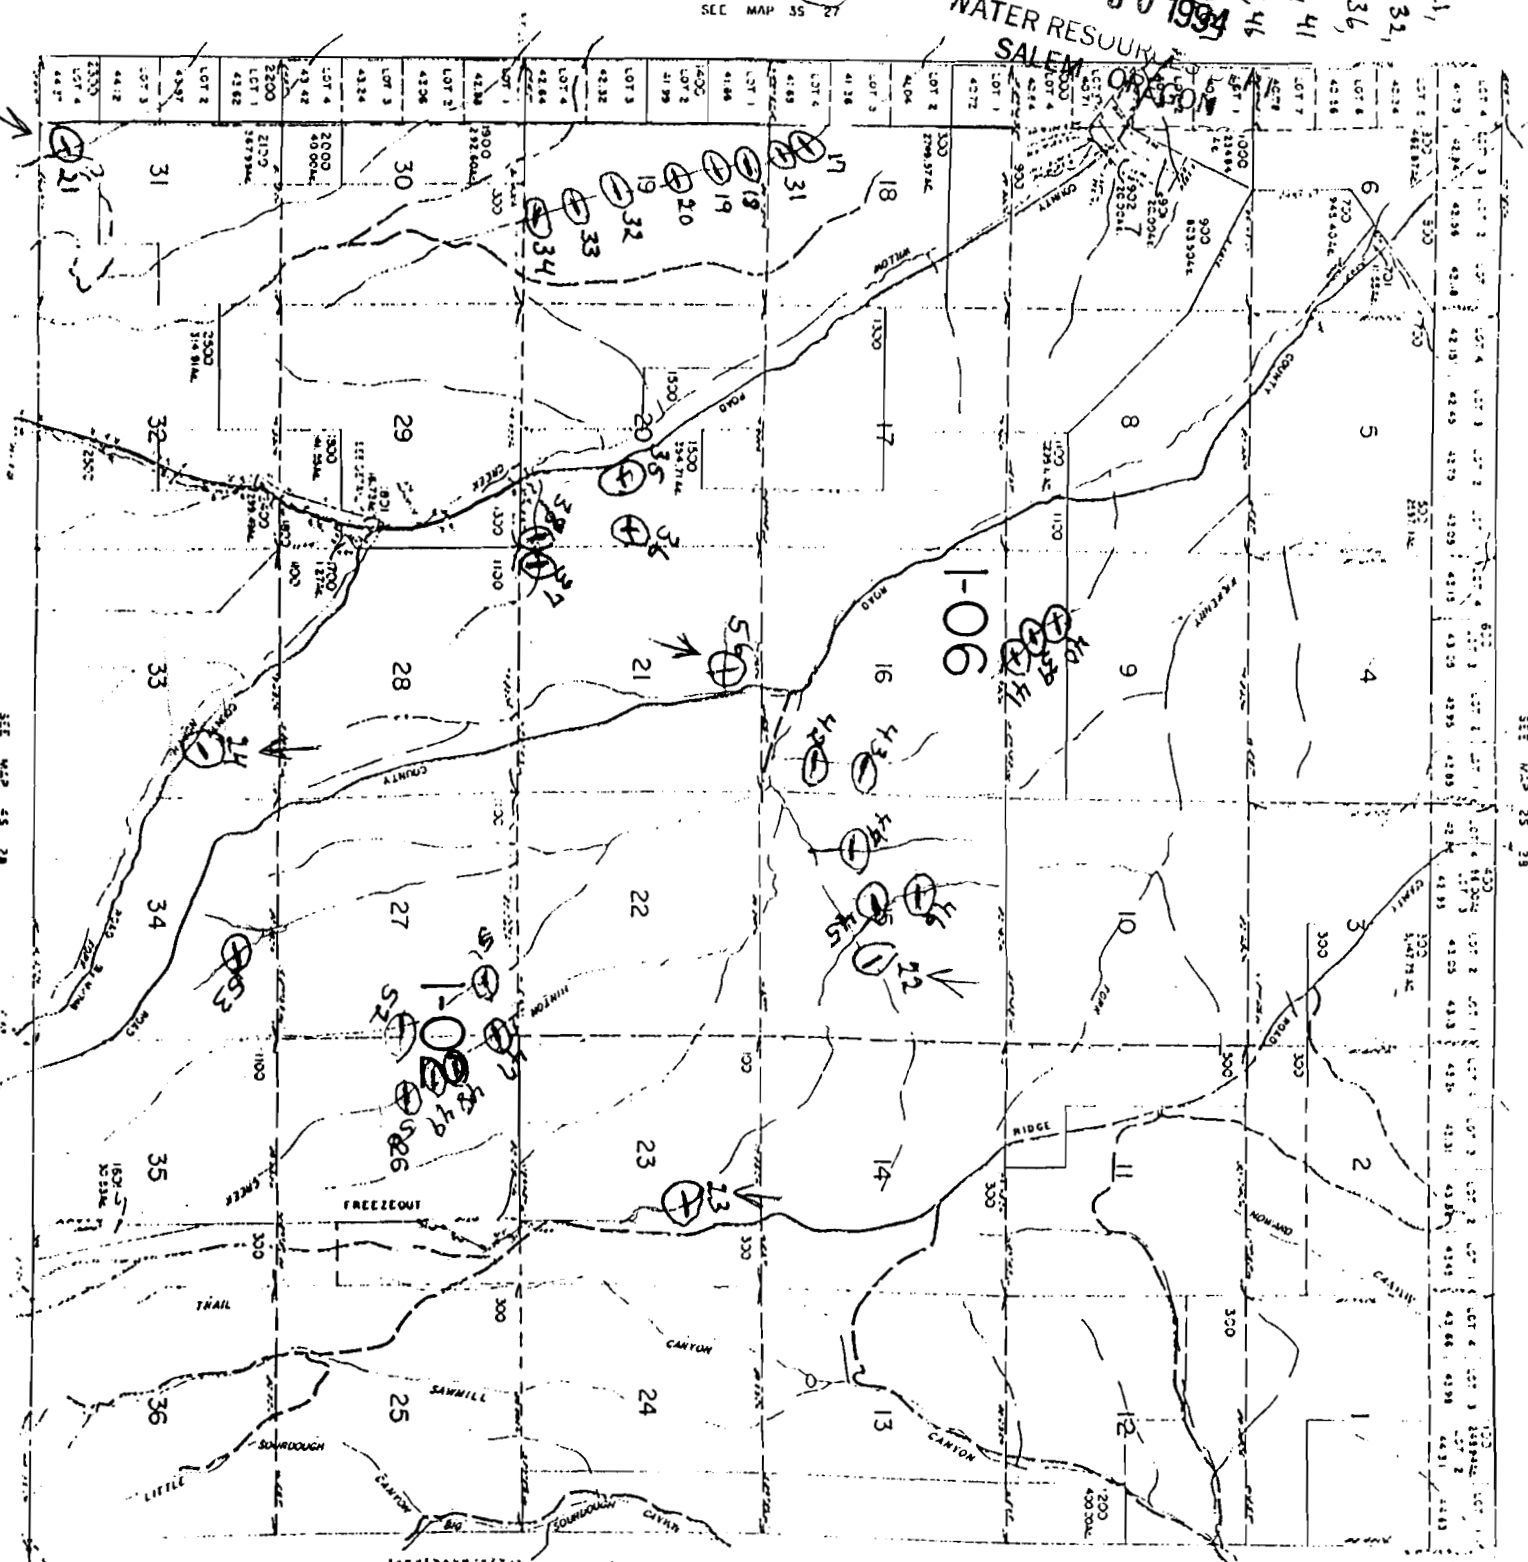

533 W-2 25 24

CANCELED
NUMBERS

1502

SEE MAP JS 29

[illegible]

Application No. R-81582
Permit No.

35 28

Order #:
25, 26, 27

RECEIVED

DEC 30 1994
WATER RESOURCES
SALEM, OREGON

4528 E

SEE MAP 27

SEE MAP 45 29

