



Prepared by UNITED STATES DEPARTMENT of AGRICULTURE * SOIL CONSERVATION SERVICE
cooperating with

OWNER
OPERATOR

FARM NO.
SCALE
DATE
ACRES
APPROXIMATE
PHOTO NO.

CONSERVATION PLAN MAP

Application No. R-77272
Permit No.

CERTIFICATE NO.

70989

Kathryn M Healy 68.750% Ownership
John J. Healy 18.750% Ownership
Rosetta Palmateer 12.500% Ownership


Rocky Hill Pasture

Camp Pasture

Sheep Pasture



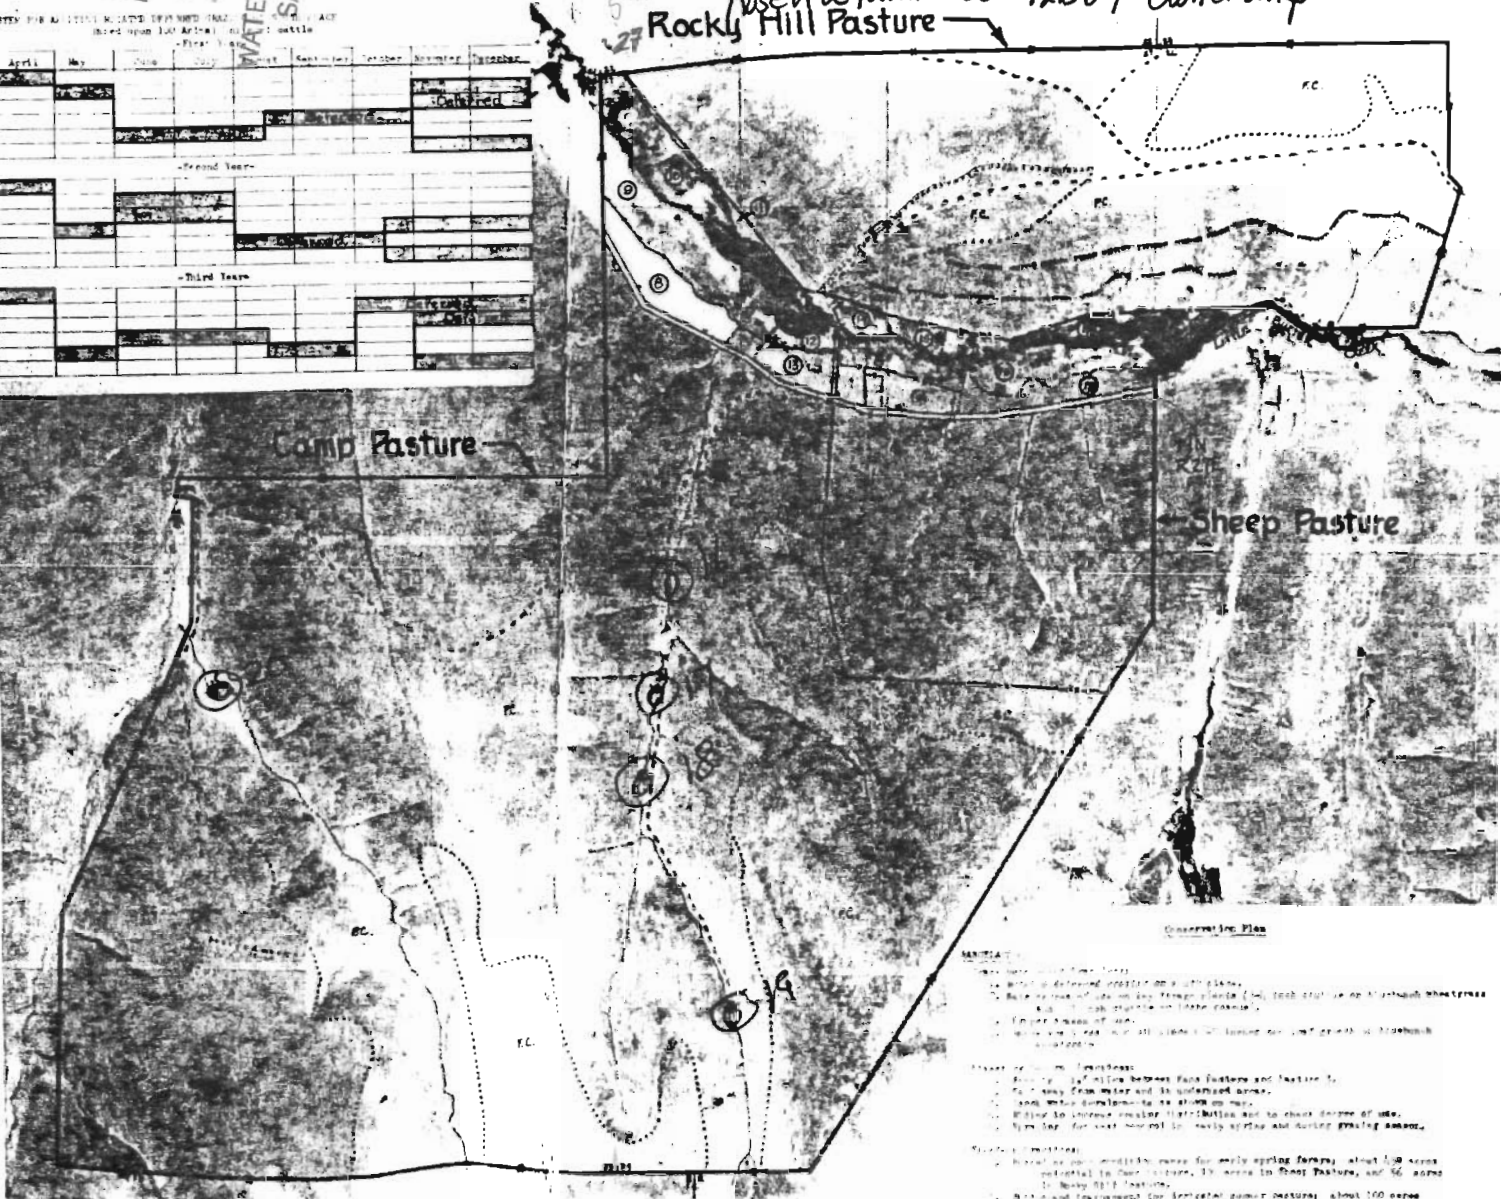

T1N R27

HB 2153

Kathryn M. Healy 68.15% Ownership
John J. Healy 18.75% Ownership
20.10 Rosetta Palma 13.50% Ownership

RECEIVED

JAN 5 1995

WALL SALL

Pasture 1

N

Pasture 2

Pasture 3



SOIL, RANGE SITE and RANGE CONDITION SURVEY SYMBOLS

KY

CONSERVATION PLAN MAP
HEALY BROS

PLAN No. 340

Heppner Soil Conservation District
OREGON

Prepared by: USDA Soil Conservation Service

Application No. R-77279
Permit No.

TIS R 27

TIS R 28

70089