


Sec. 34 T. 6 N. R. 35 E

Umatilla Co
Ore.

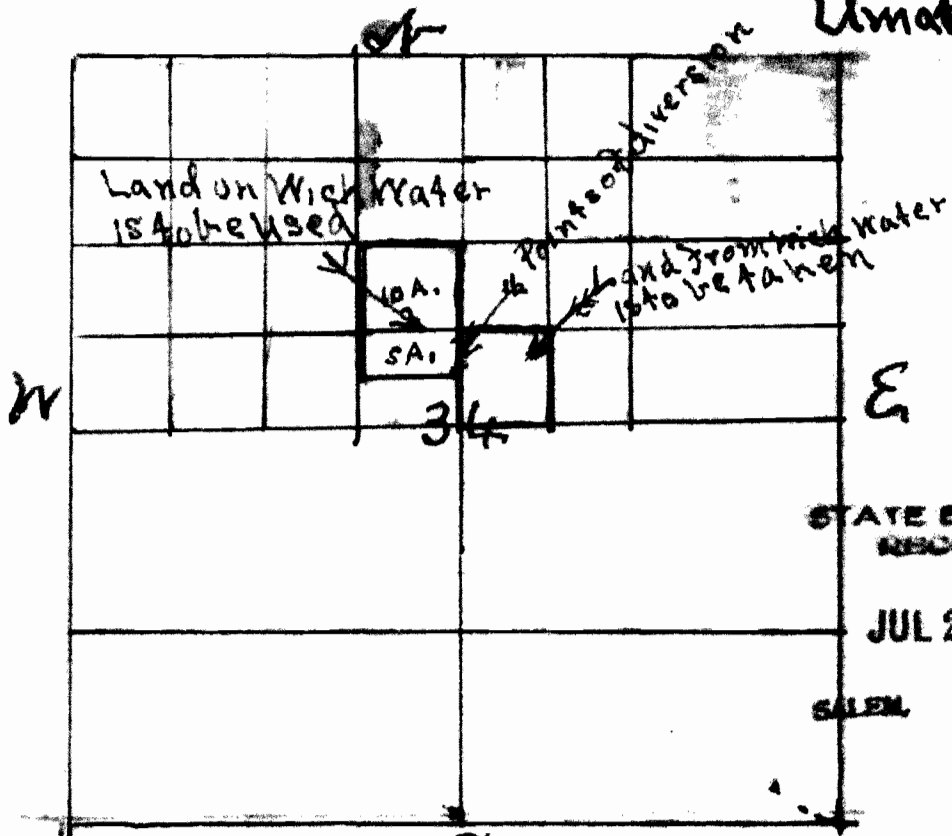

10303

STATE ENGINEER
RECEIVED

JUL 23 1925

SALEM OREGON

Application No. 10303
Permit No. 6849