



T. 3N., R. 28E., W. M.

G-10292
75422
64441
75132

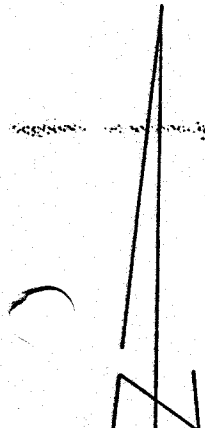

SCALE 1" = 1320'

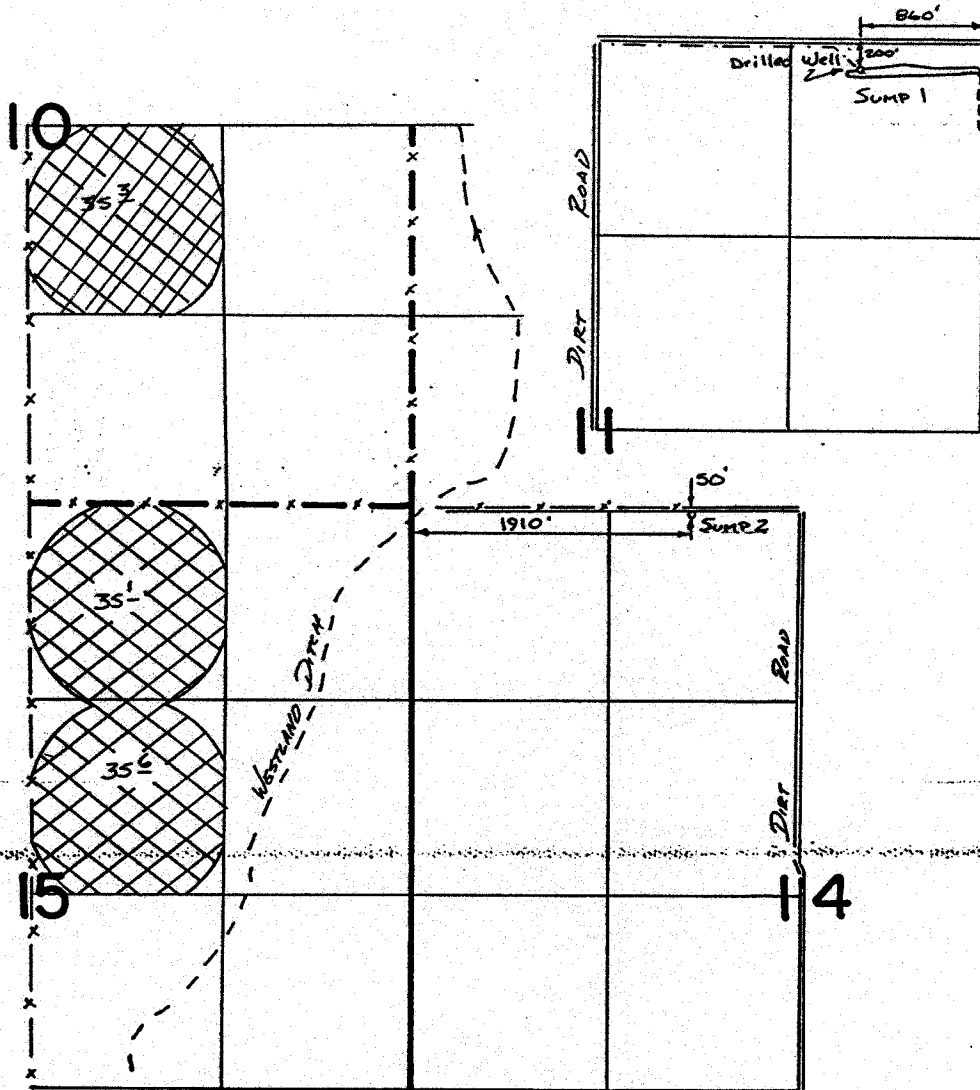

FINAL PROOF SURVEY
UNDER

Application No. **G:11182** Permit No. **G:10292**
 IN NAME OF
JOHN N. CORREA
 Surveyed **8:5** 19**87**, by **V.L. Church**