


T.40S., R.8&9W., W.M.

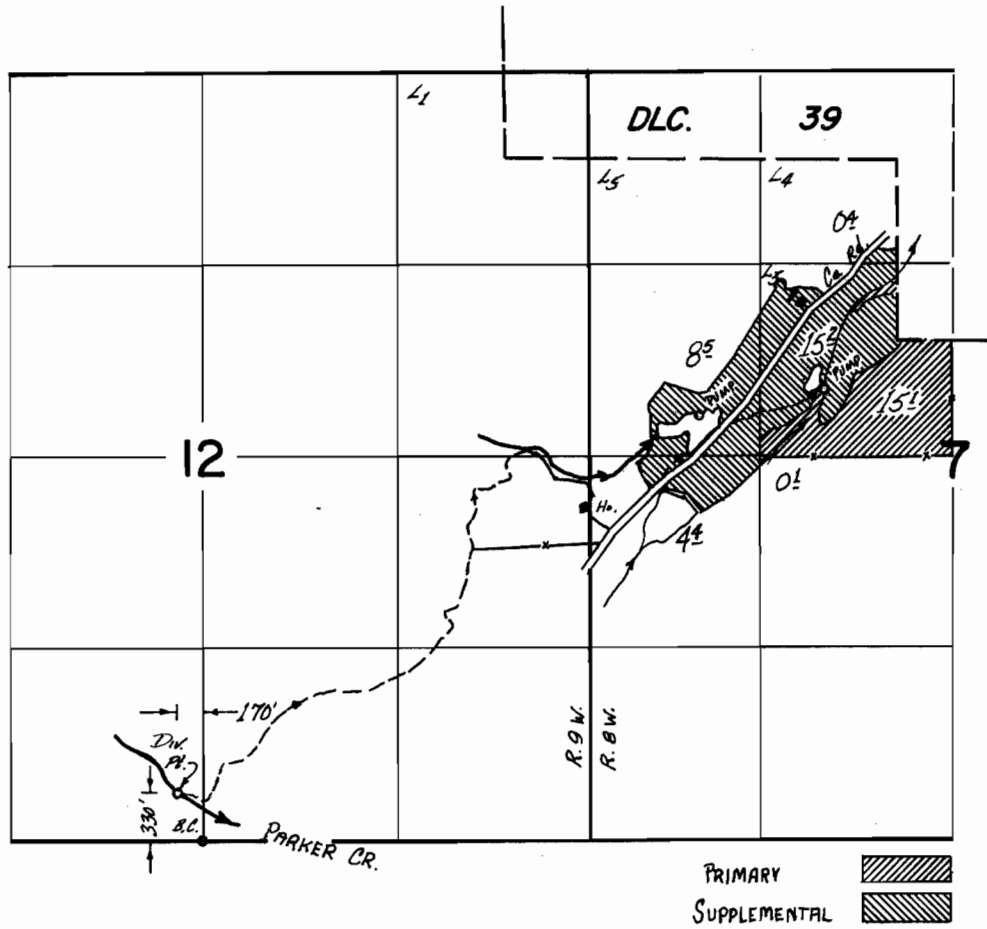

FINAL PROOF SURVEY
UNDER

Application No. 40992 Permit No. 30566
IN NAME OF

WENDELL M. FALES

Surveyed 31 Oct. 1972, by L. E. GOULD