


T.40S., R.88&9W., W.M.

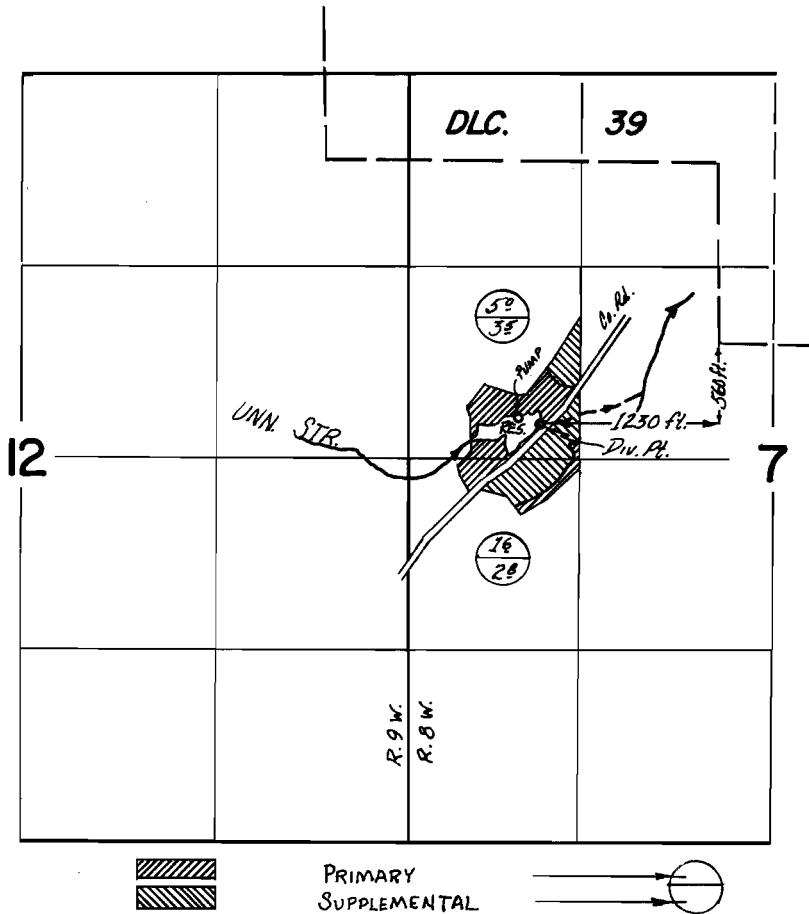

**FINAL PROOF SURVEY**  
UNDER

R-40383                      R-4513  
Application No. 40384    Permit No. 30106  
IN NAME OF

WENDELL M. FALES

Surveyed 31 Oct. 1972, by L.E. GOULD