


T.17S. R.5 W.W.M.

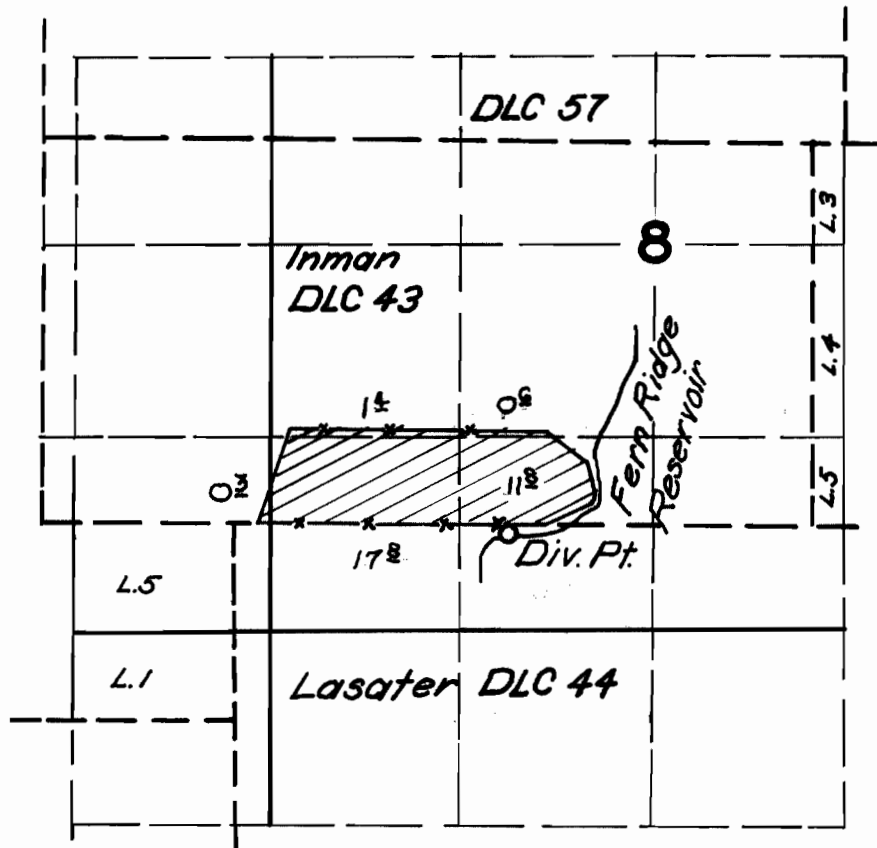

FINAL PROOF SURVEY
UNDER

Application No. 32992 Permit No. 26089
IN NAME OF

Ben Inman

Surveyed 24 May 1962, by Carl R. Baker