


T1S.R3 & 4W, WM

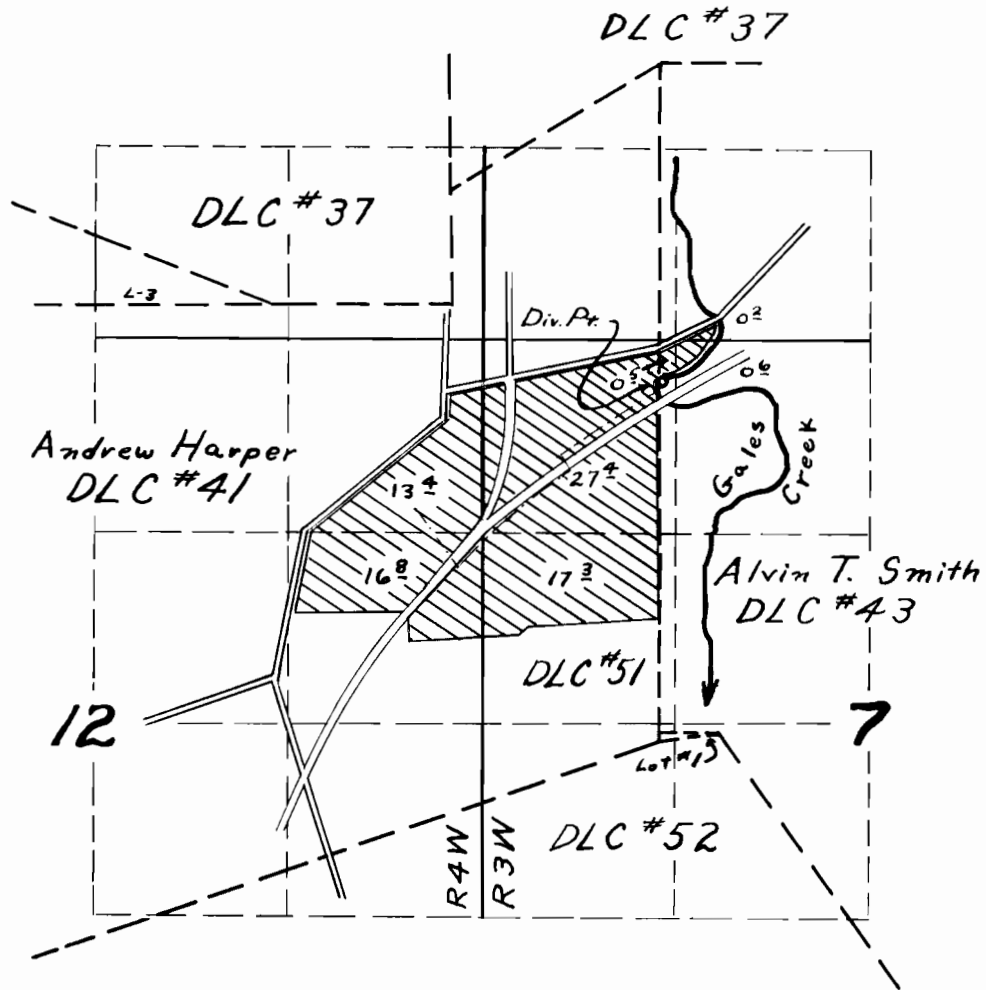

FINAL PROOF SURVEY

UNDER

Application No. 28733 Permit No. 22652

IN NAME OF

Lanore C. & Alma Lyda

Surveyed 4-27 1956, by R.D. Best