


75144
 T6604
 T6828
 81168
 T6828

T.13S.,R.12E.,W.M.

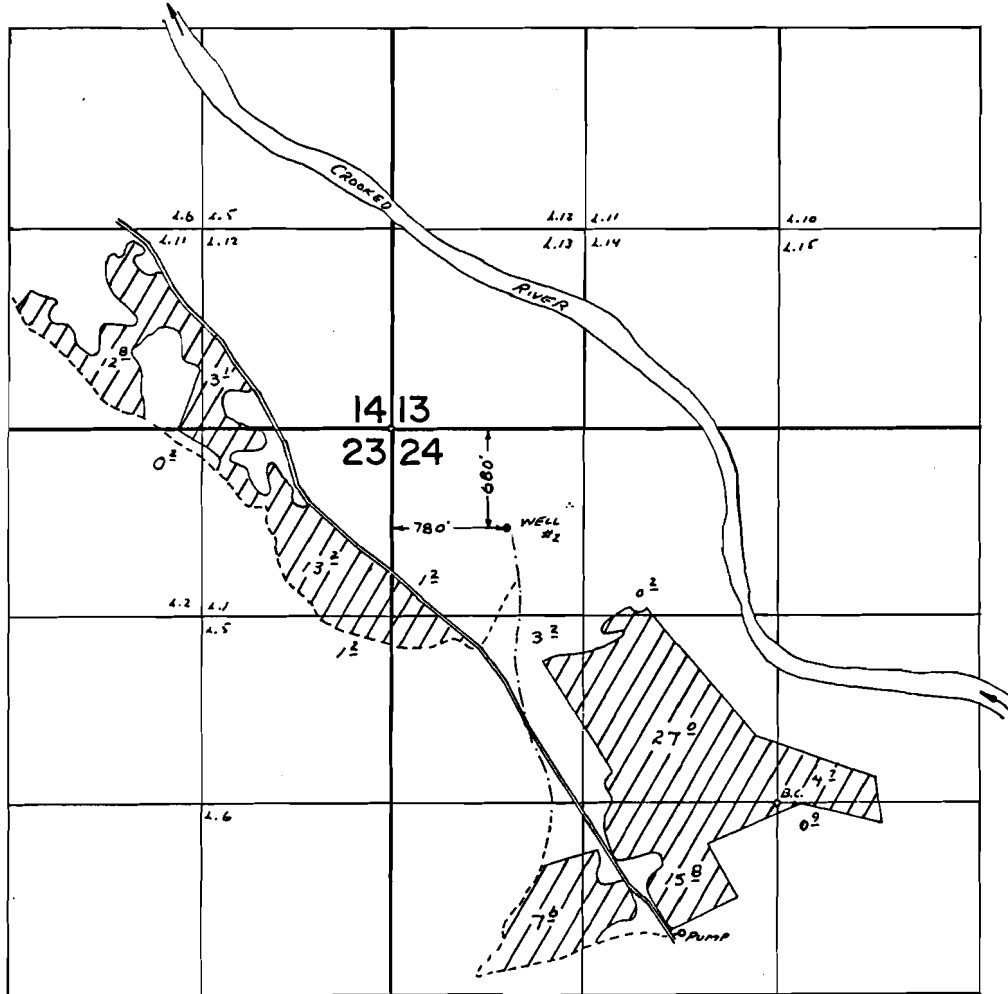

FINAL PROOF SURVEY UNDER

Application No. G-2278 Permit No. G-2280
 IN NAME OF

CROOKED RIVER RANCH WATER COMPANY

Surveyed JUNE 19, 1975, by L.E. GAULD.....

G-2280
 DOU-SH-208 LMT