


T.5S.R.IIW.W.M.

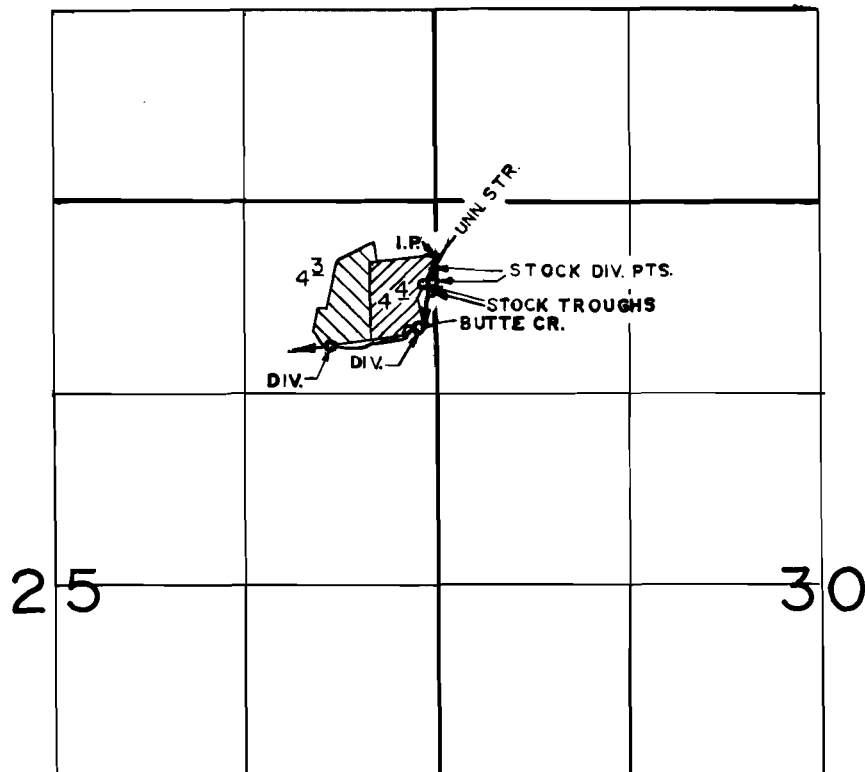

BUTTE CR. DIV. PTS. LOC.: 850' S. & 120' W.; 1000' S. & 740' W.;
UNN. STR. DIV. PTS. LOC.: 460' S. & 10' W.; 550' S. & 20' W.;
ALL FROM NE. COR. SEC. 25

 - Permit No. 43234
 - Permit No. 44661

FINAL PROOF SURVEY UNDER

58763 44661
Application No. 57455. Permit No. 43234.....
IN NAME OF

.....GERALD & JUDY MORROW.....

Surveyed JAN. 22.. 1980, by R.G. MUCKEN.....