


T. 40S. R. 13W. W.M.

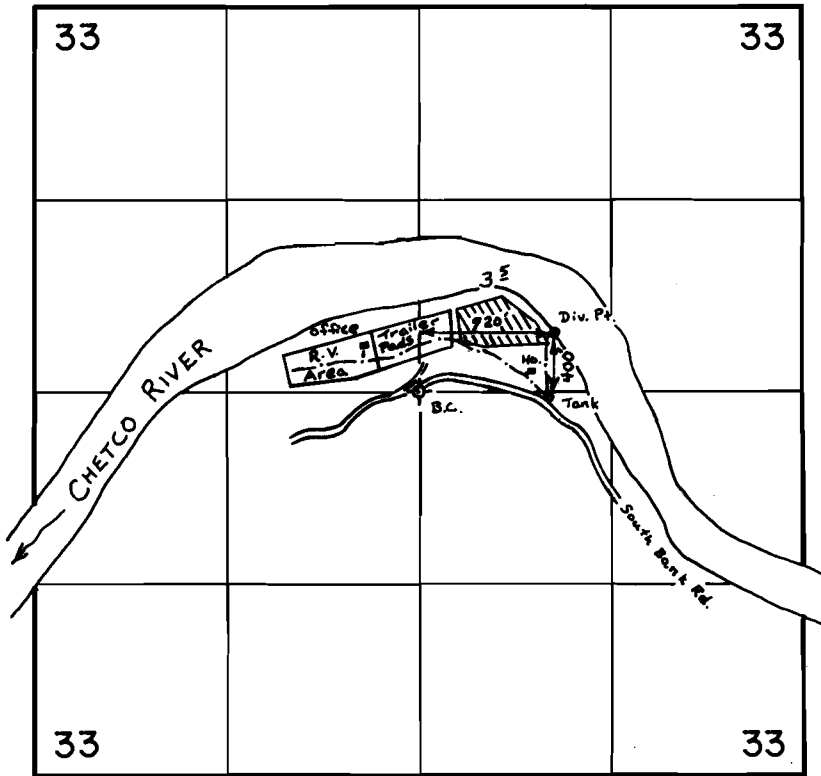

SCALE: 4" = 1 mile

**FINAL PROOF SURVEY
UNDER**

51190 38682
Application No. 43797 Permit No. 32724
IN NAME OF

THOMAS M. MCKENZIE

Surveyed July 19, 1978, by D. Sparks