


Per # 7048
7517

10021

Township 11 S Range 30 E 8 M.

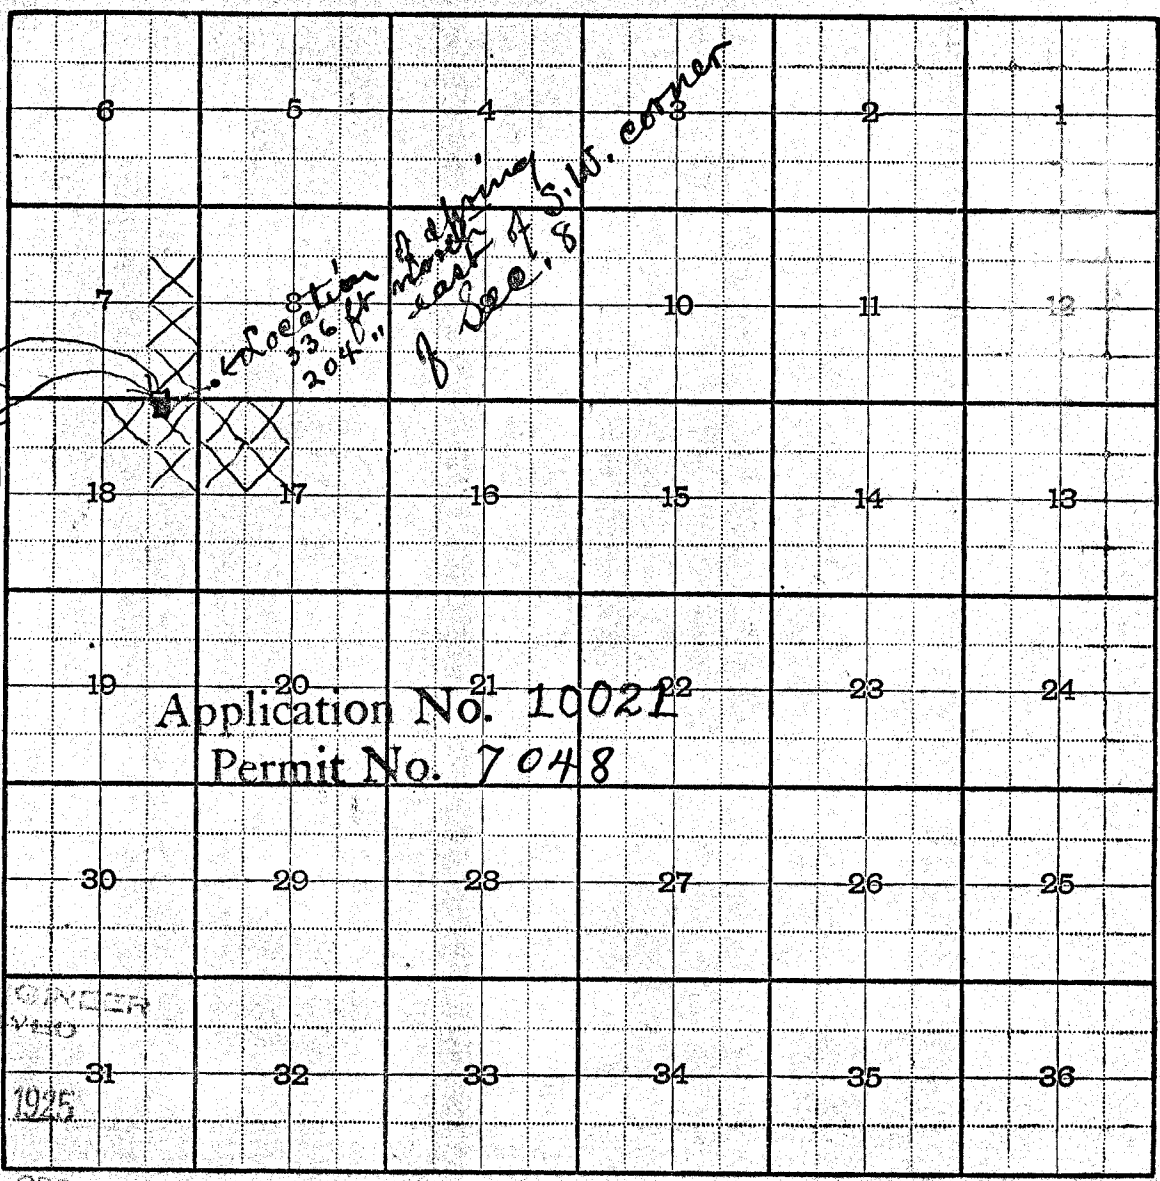

Garden is (House) located as follows
1 acre of land in
in NW corner of
N.E. 1/4 of N.E. 1/4 of
Sec. 18
1 acre of land in
S.W. corner of SE 1/4
the SE 1/4 of Sec. 17

STATE ENGINEER
RECEIVED
MAR 13 1925
SALEM,

G. G. Carson, Appropriator
Beech Creek
Grant Co, Oregon