


75223
T4703

~~T. 14 S. R. 16 E. W. M.~~
T. 14 S. R. 16 E. W. M.

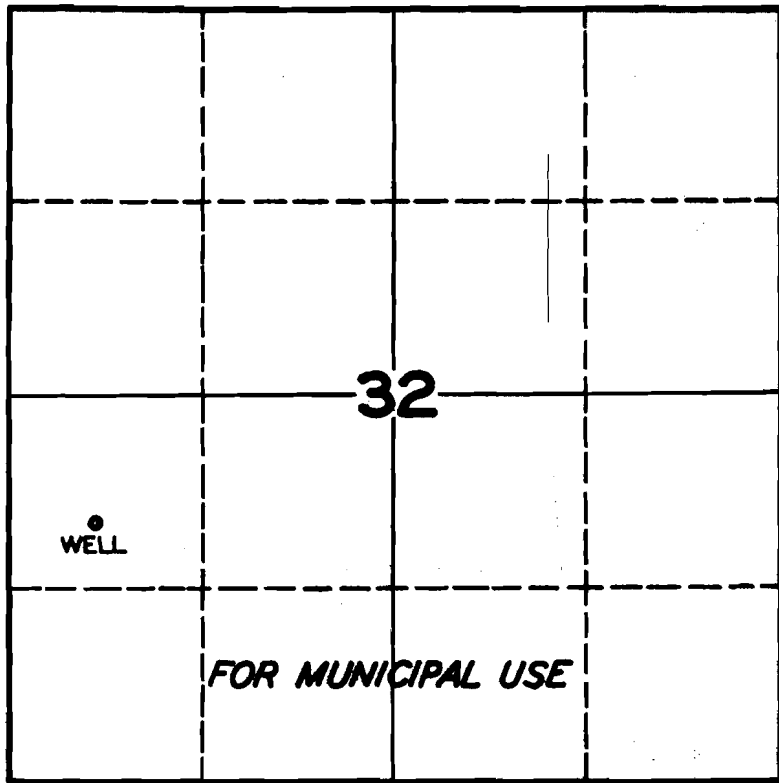

FINAL PROOF SURVEY
UNDER

Application No. U-147 Permit No. U-140

IN NAME OF
PACIFIC POWER & LIGHT CO.

Surveyed APR. 30 1946 by *[Signature]*