
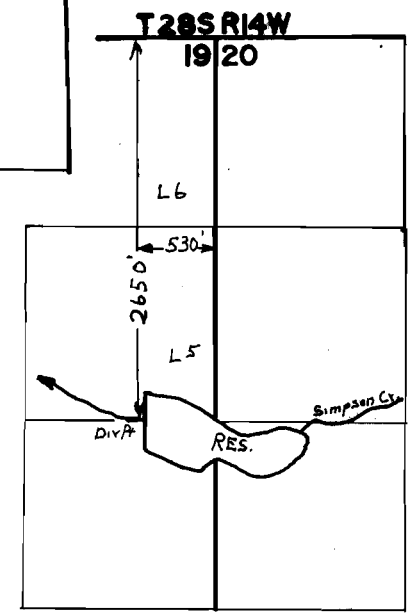


T.28S., R.14W., W.M.

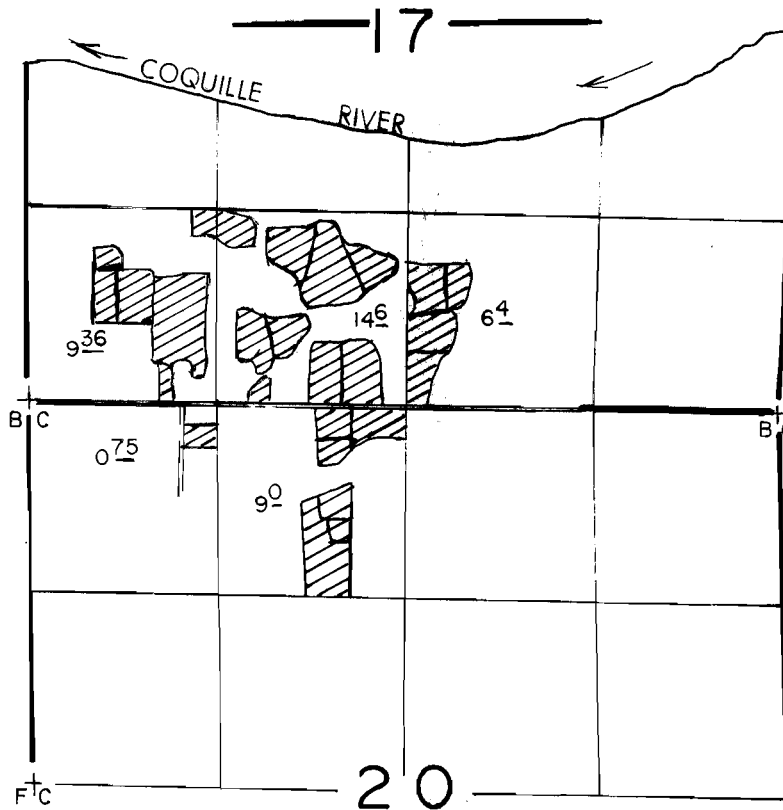

SCALE: 1"=1320'

**FINAL PROOF SURVEY
UNDER**

Application No. 57072... Permit No. 47492.....
IN NAME OF

.....PROSPER...WATER...DIST.....

Surveyed SEPT. 20... 1989., by B.S. JAMES.....