


# T.28S., R.14 W., W.M.

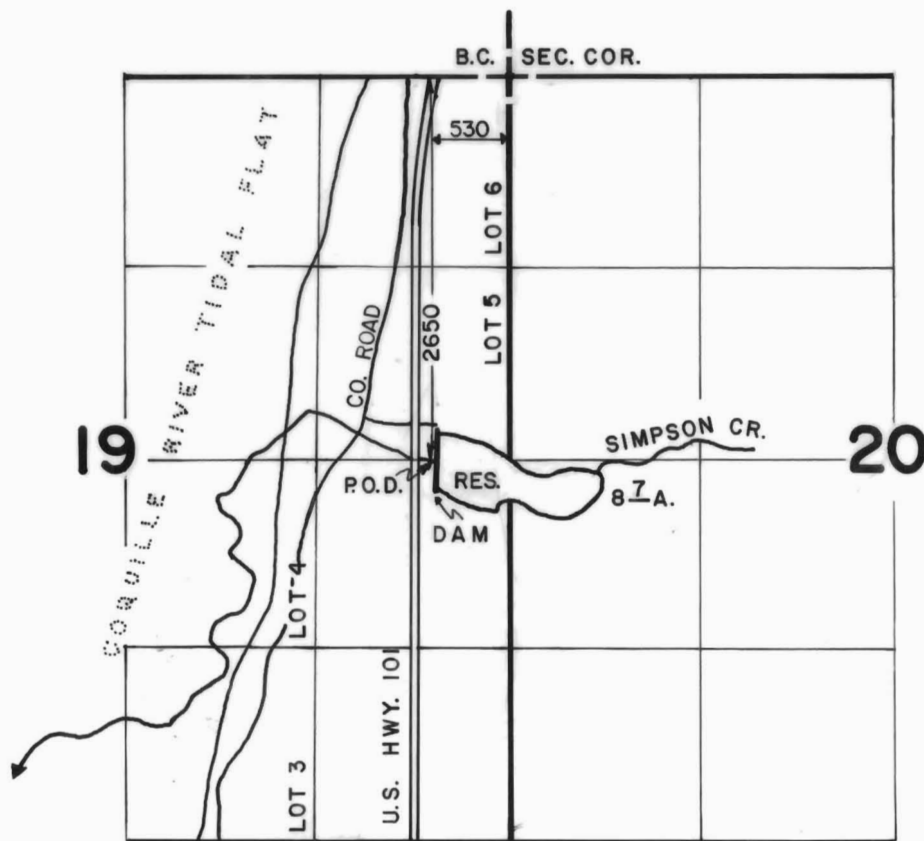

SCALE 4" = 1 MILE

## FINAL PROOF SURVEY

UNDER

Application No. R-58295 Permit No. R-8647

IN NAME OF

PROSPER WATER DISTRICT

Surveyed OCT. 23, 1985, by J.M. SCHMORDE