


# T. 22 S., R. 10 W., W.M.

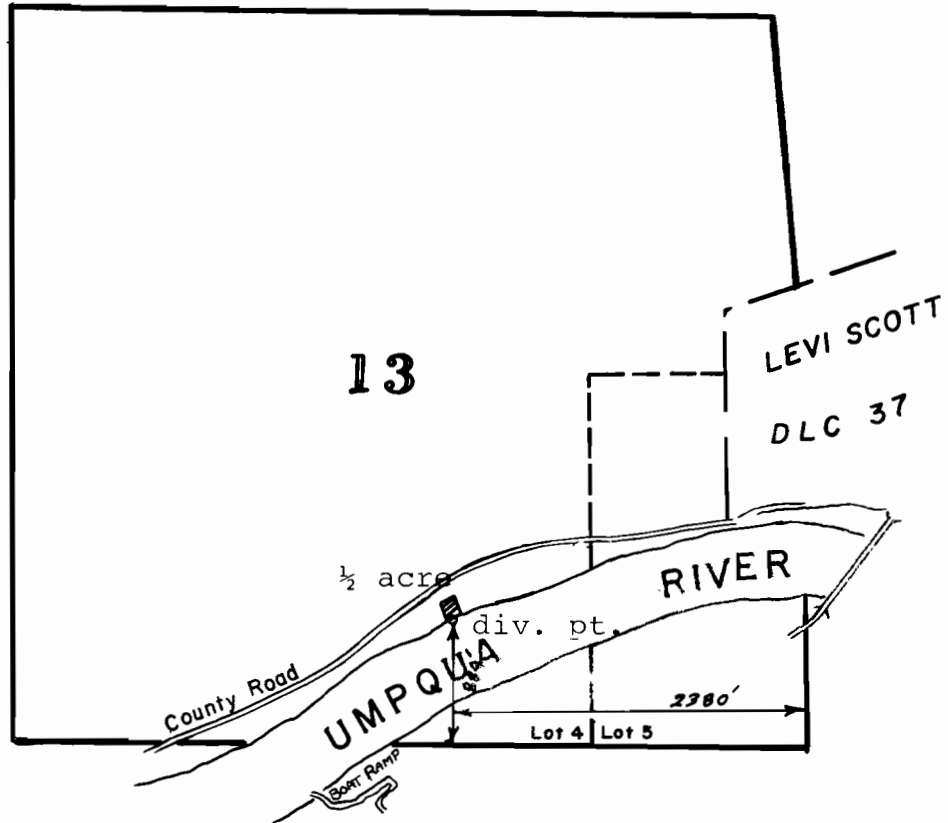

Scale 1" = 1320'



## FINAL PROOF SURVEY UNDER

Application No. 51587. Permit No. 38912.....  
IN NAME OF

ARTHUR HAYS

Surveyed Sept. 14, 1990, by KEN KEMP.....  
May 19, 1994, by B.S. James