


T. 33 S., R. 15 W., W.M.

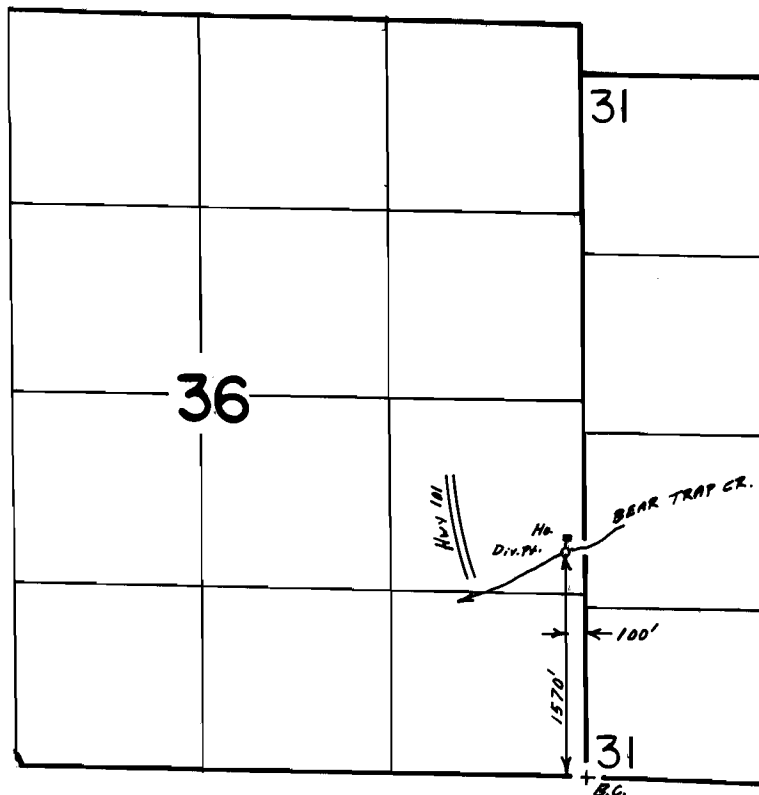

Scale 1"=1320'

FINAL PROOF SURVEY
UNDER

Application No. 64498 Permit No. 47162

IN NAME OF

BAJA HUMBUG OF OR. LTD.,
JONATHAN S. BENJAMIN

Surveyed Sept. 24, 1991, by B.S. James