



T. 37 S., R. 2 E., W.M.

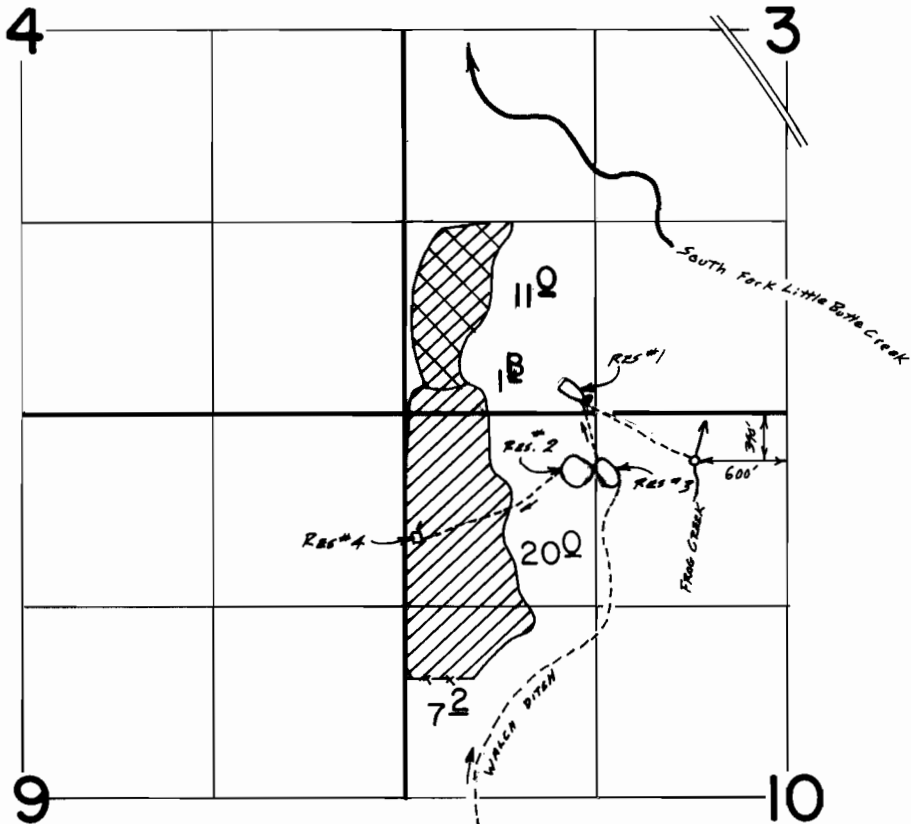

DAM 1 - 200 ft N. & 1070 ft E; DAM 2 - 400 ft S. & 1070 ft E; DAM 3 - 400 ft S. & 1320 ft E; DAM 4 - 850 ft S & 50 ft E; ALL FROM THE NW CORNER SECTION 10.

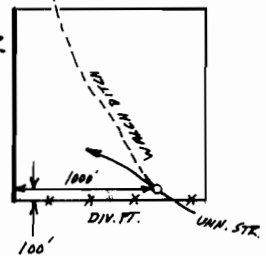

FINAL PROOF SURVEY
UNDER

Sec. 35

R-64604 R-8610
Application No. ~~64605~~ Permit No. ~~47440~~...
IN NAME OF

.....JERRY & or SHIRLEY STONE

Surveyed Aug. 12, 1991., by S. James.....