


# T. 34 & 35 S., R. 2 W., W. M.

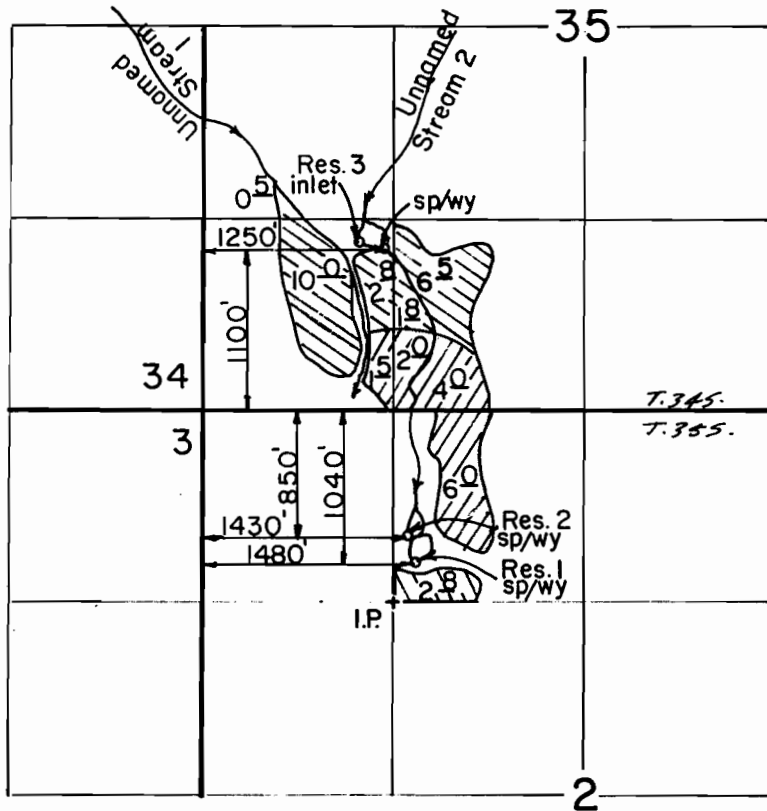

Scale: 1" = 1320'

- Res. 1
- Res. 2
- Res. 3

## FINAL PROOF SURVEY UNDER

R-66410                      R-9098 ✓  
 Application No. 66411. Permit No. 48081...  
 IN NAME OF

.....JERRY...M...MC...CAULEY.....

Surveyed JULY.3. 1991., by B.S. JAMES....