


T. 27S., R. 7W., W.M.

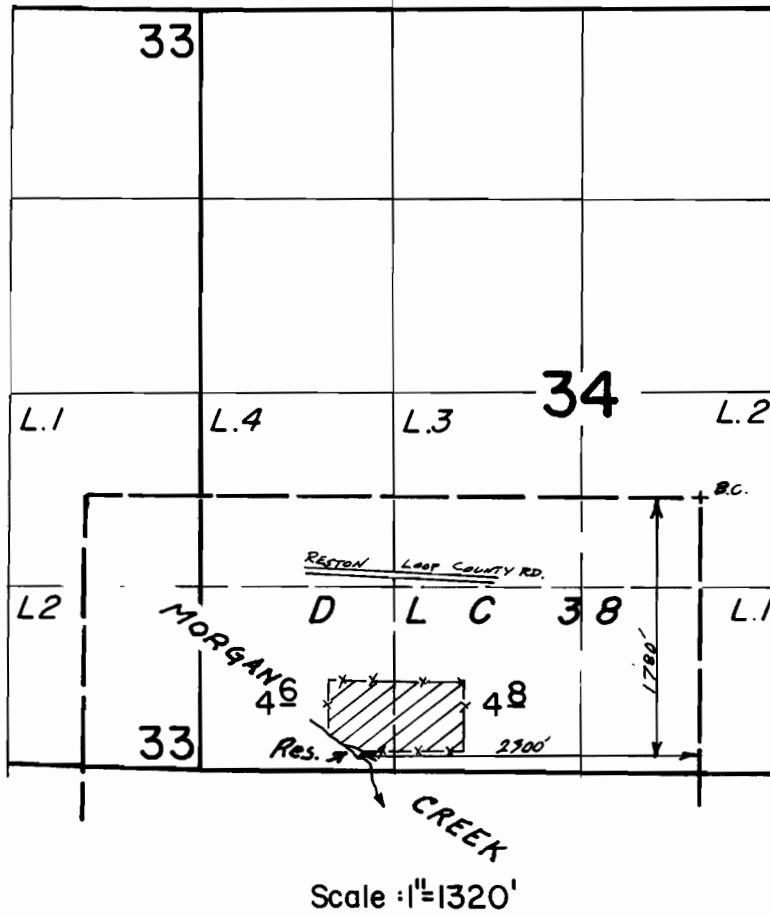

FINAL PROOF SURVEY
UNDER

R-67731 R-9392
Application No. 67.732 Permit No. 48262...
IN NAME OF

LARRY B. ELLENWOOD

Surveyed June 28, 1988, by J.M. Schmorda..
August 29, 1990, by S. James