


T. 27S., R. 7W., W.M.

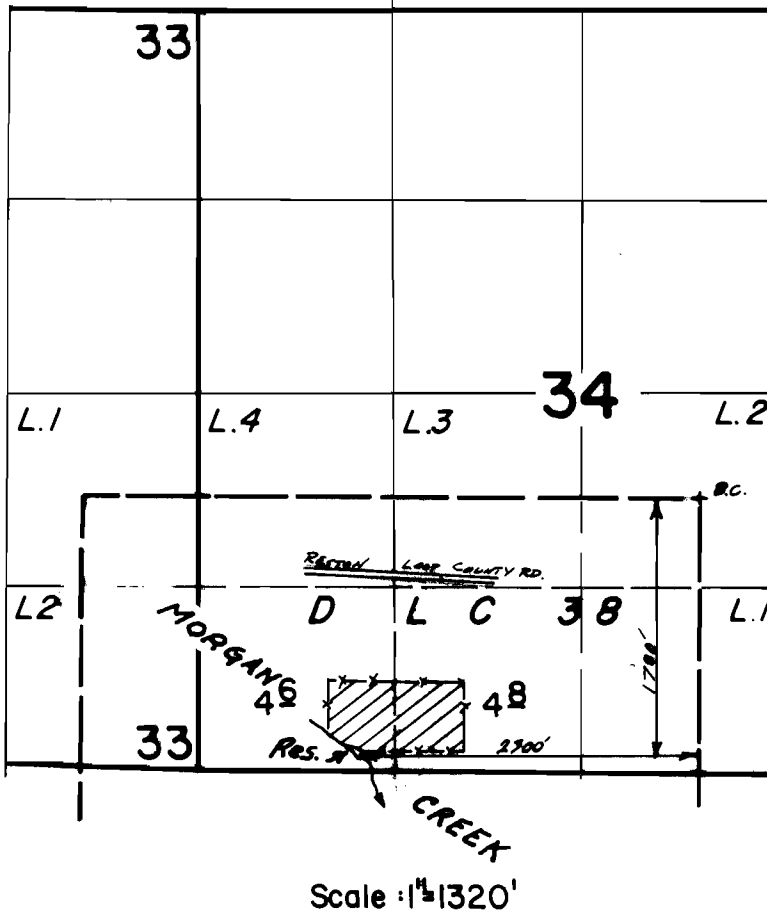

**FINAL PROOF SURVEY
UNDER**

R-67731 R-9392
Application No. 67732 Permit No. 48262...
IN NAME OF

..... **LARRY B. ELLENWOOD**

Surveyed **JUNE 28, 1988**, by J.M.Schmorde..
August 29, 1990, by S. James