


T. 29 S., R. 5 W., W.M.

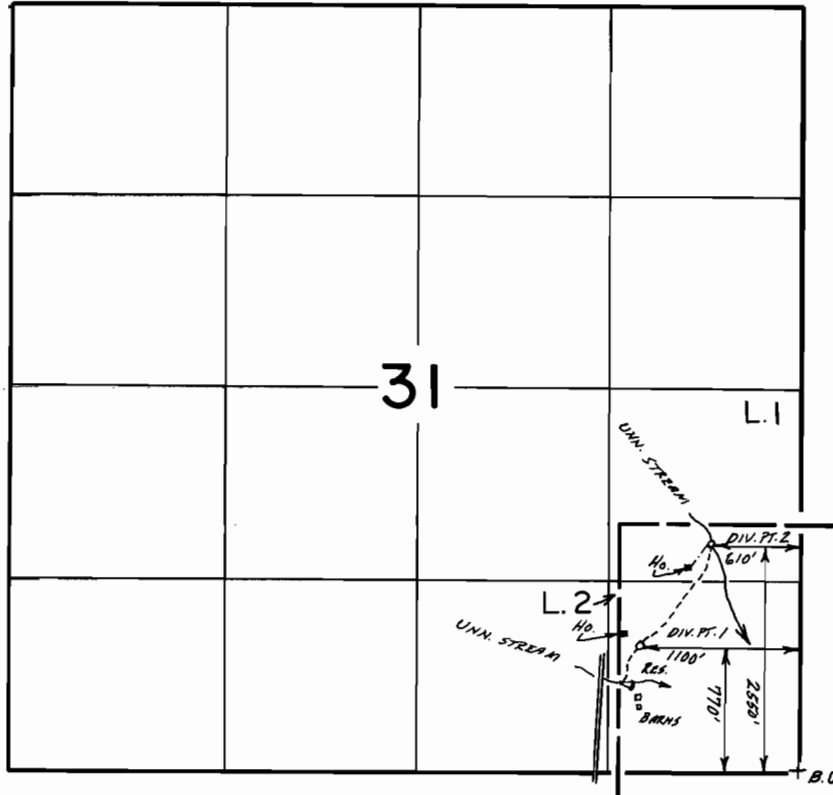

Scale 1"=1320'

FINAL PROOF SURVEY UNDER

Application No. 49823 Permit No. 36788
IN NAME OF

.....HOWARD J. GEYER.....

Surveyed FEB. 20, 1990, by B.S. JAMES.....
MAY 20, 1986, by J.M. SCHMORDE