


T. 21 S., R. 5 W., W. M.

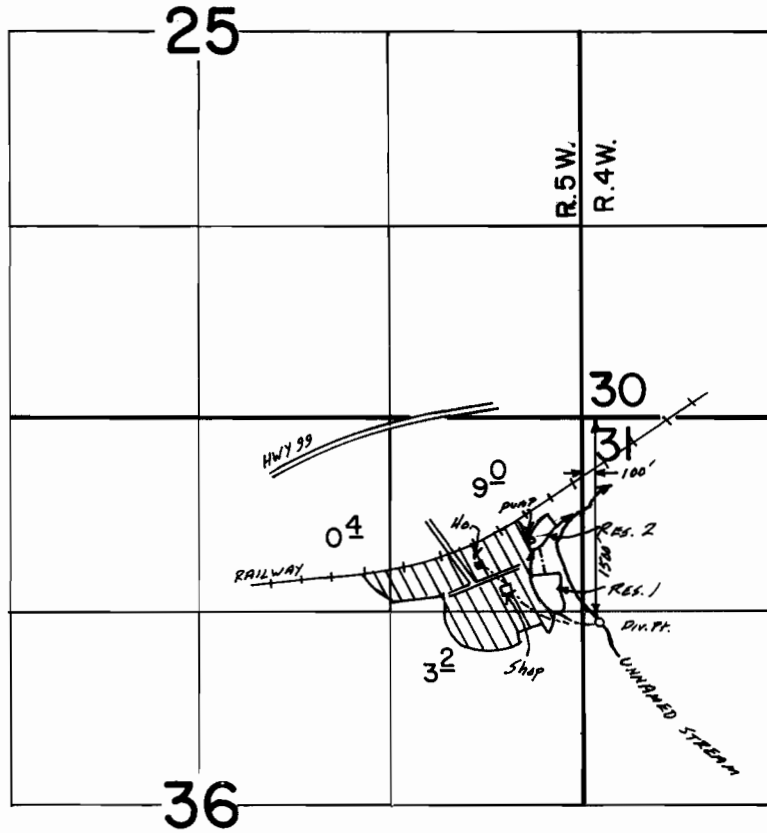

Scale 1"=1320'

FINAL PROOF SURVEY
UNDER

R-58746 R-7917
Application No. 58747 Permit No. 44359
IN NAME OF

.....FRANCIS.....GAIL.....HURD.....

Surveyed Sept. 18, 1991., by S. James.....