


T. 38S., R. 1W., W.M.

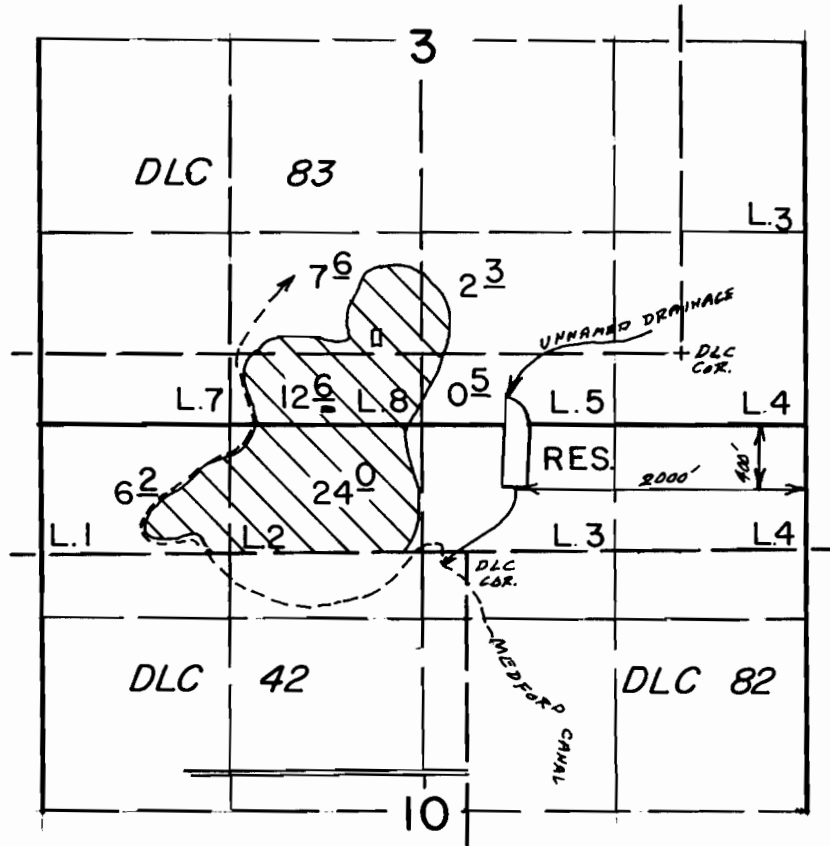

Scale: 1" = 1320'

FINAL PROOF SURVEY

UNDER

R-62126 R-8397

Application No. 62165 Permit No. 46644

IN NAME OF

...DAVID...H...HOLMES.....

Surveyed April 28, 1993., by B.S. JAMES.....