


T. 38 S., R. 1 W., W. M.

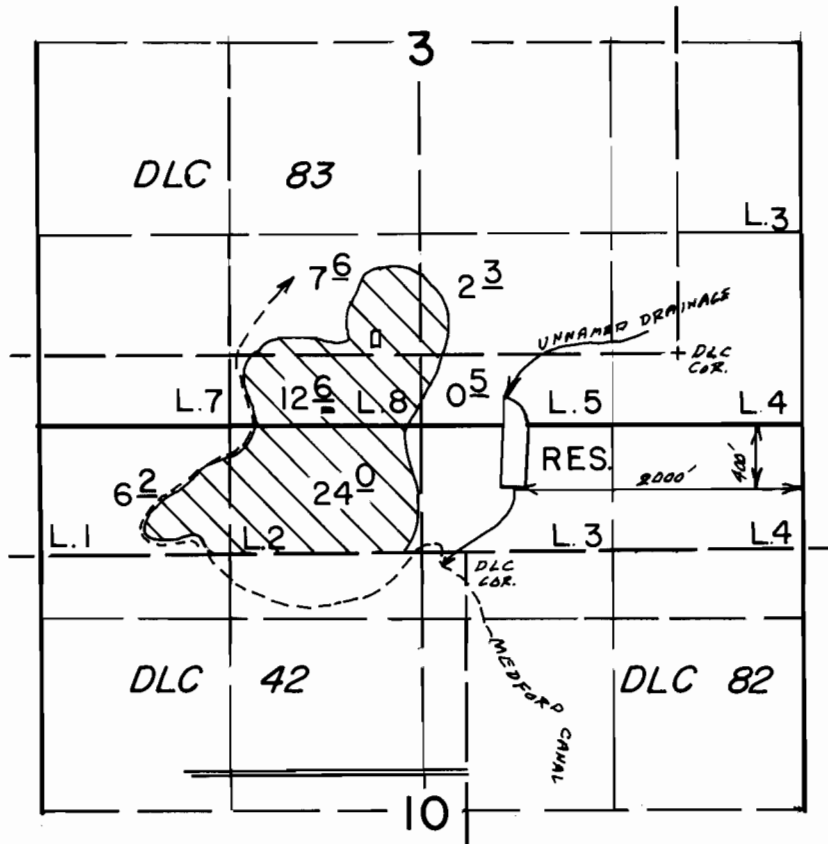

Scale: 1" = 1320'

### FINAL PROOF SURVEY

UNDER

R-62126                      R-8397

Application No. 62165    Permit No. 46644....

IN NAME OF

....DAVID....H....HOLMES.....

Surveyed April. 28, 1993., by B.S. JAMES.....