


P 48236
C-75250

T.13S., R.32E., W.M.

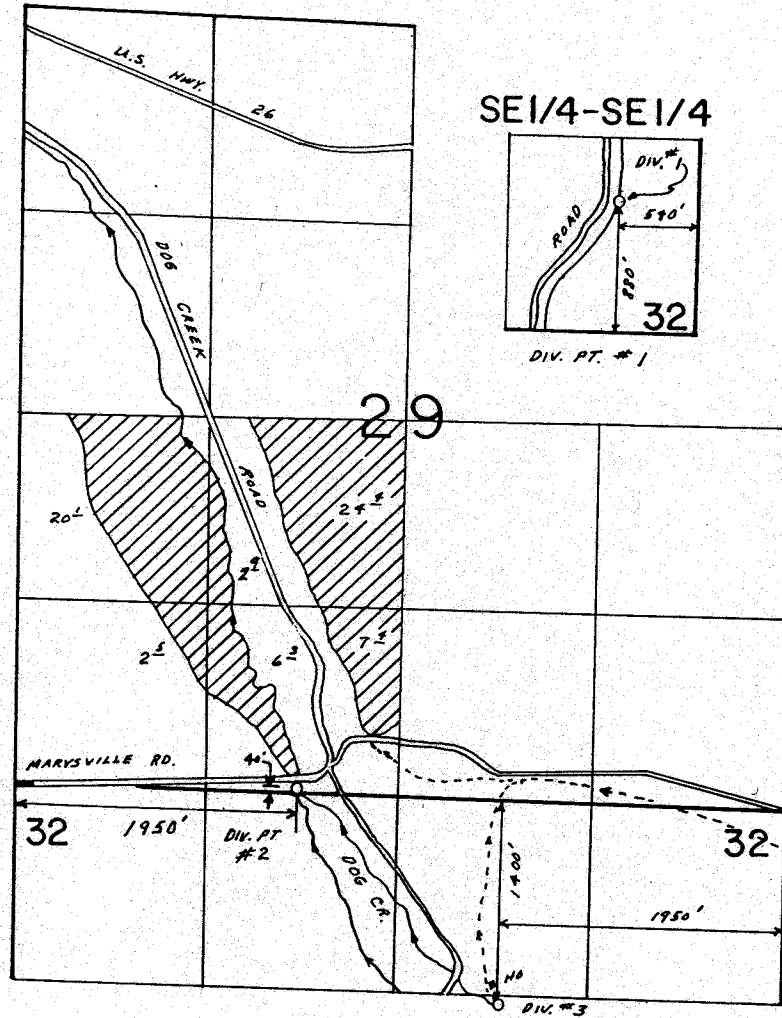

SCALE: 1"=1320'

FINAL PROOF SURVEY
UNDER

Application No. 66665. Permit No. 48236.....

IN NAME OF

ELLIOTT LIVESTOCK CORP.

Surveyed JULY 6, 1987, by V.L. CHURCH.....