


26

T. 1 N., R. 1 & 2 W., W.M.

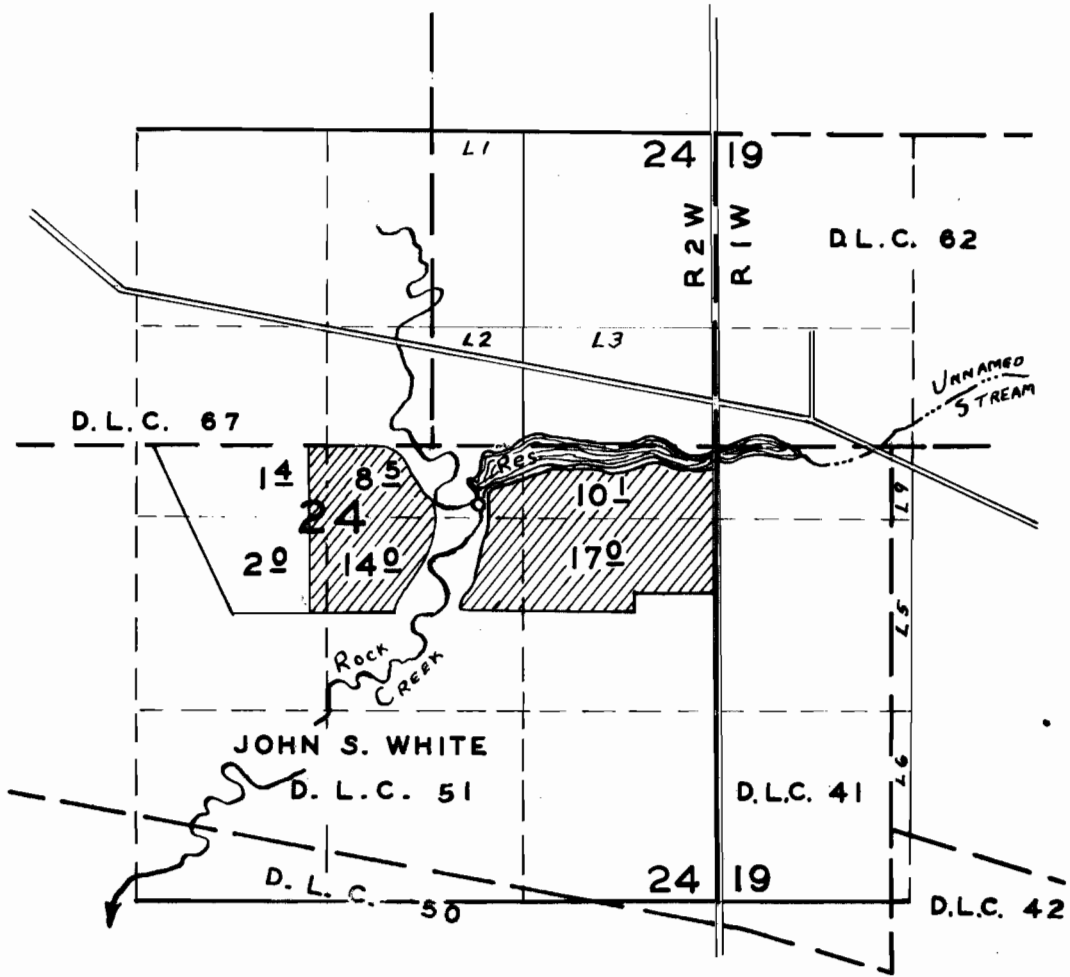

FINAL PROOF SURVEY

UNDER
 R-25947 R-1216
 Application No. 25948 Permit No. 20544
 IN NAME OF

..... W. JEFFRIES

Surveyed 4 - 10 1956, by M. BISH