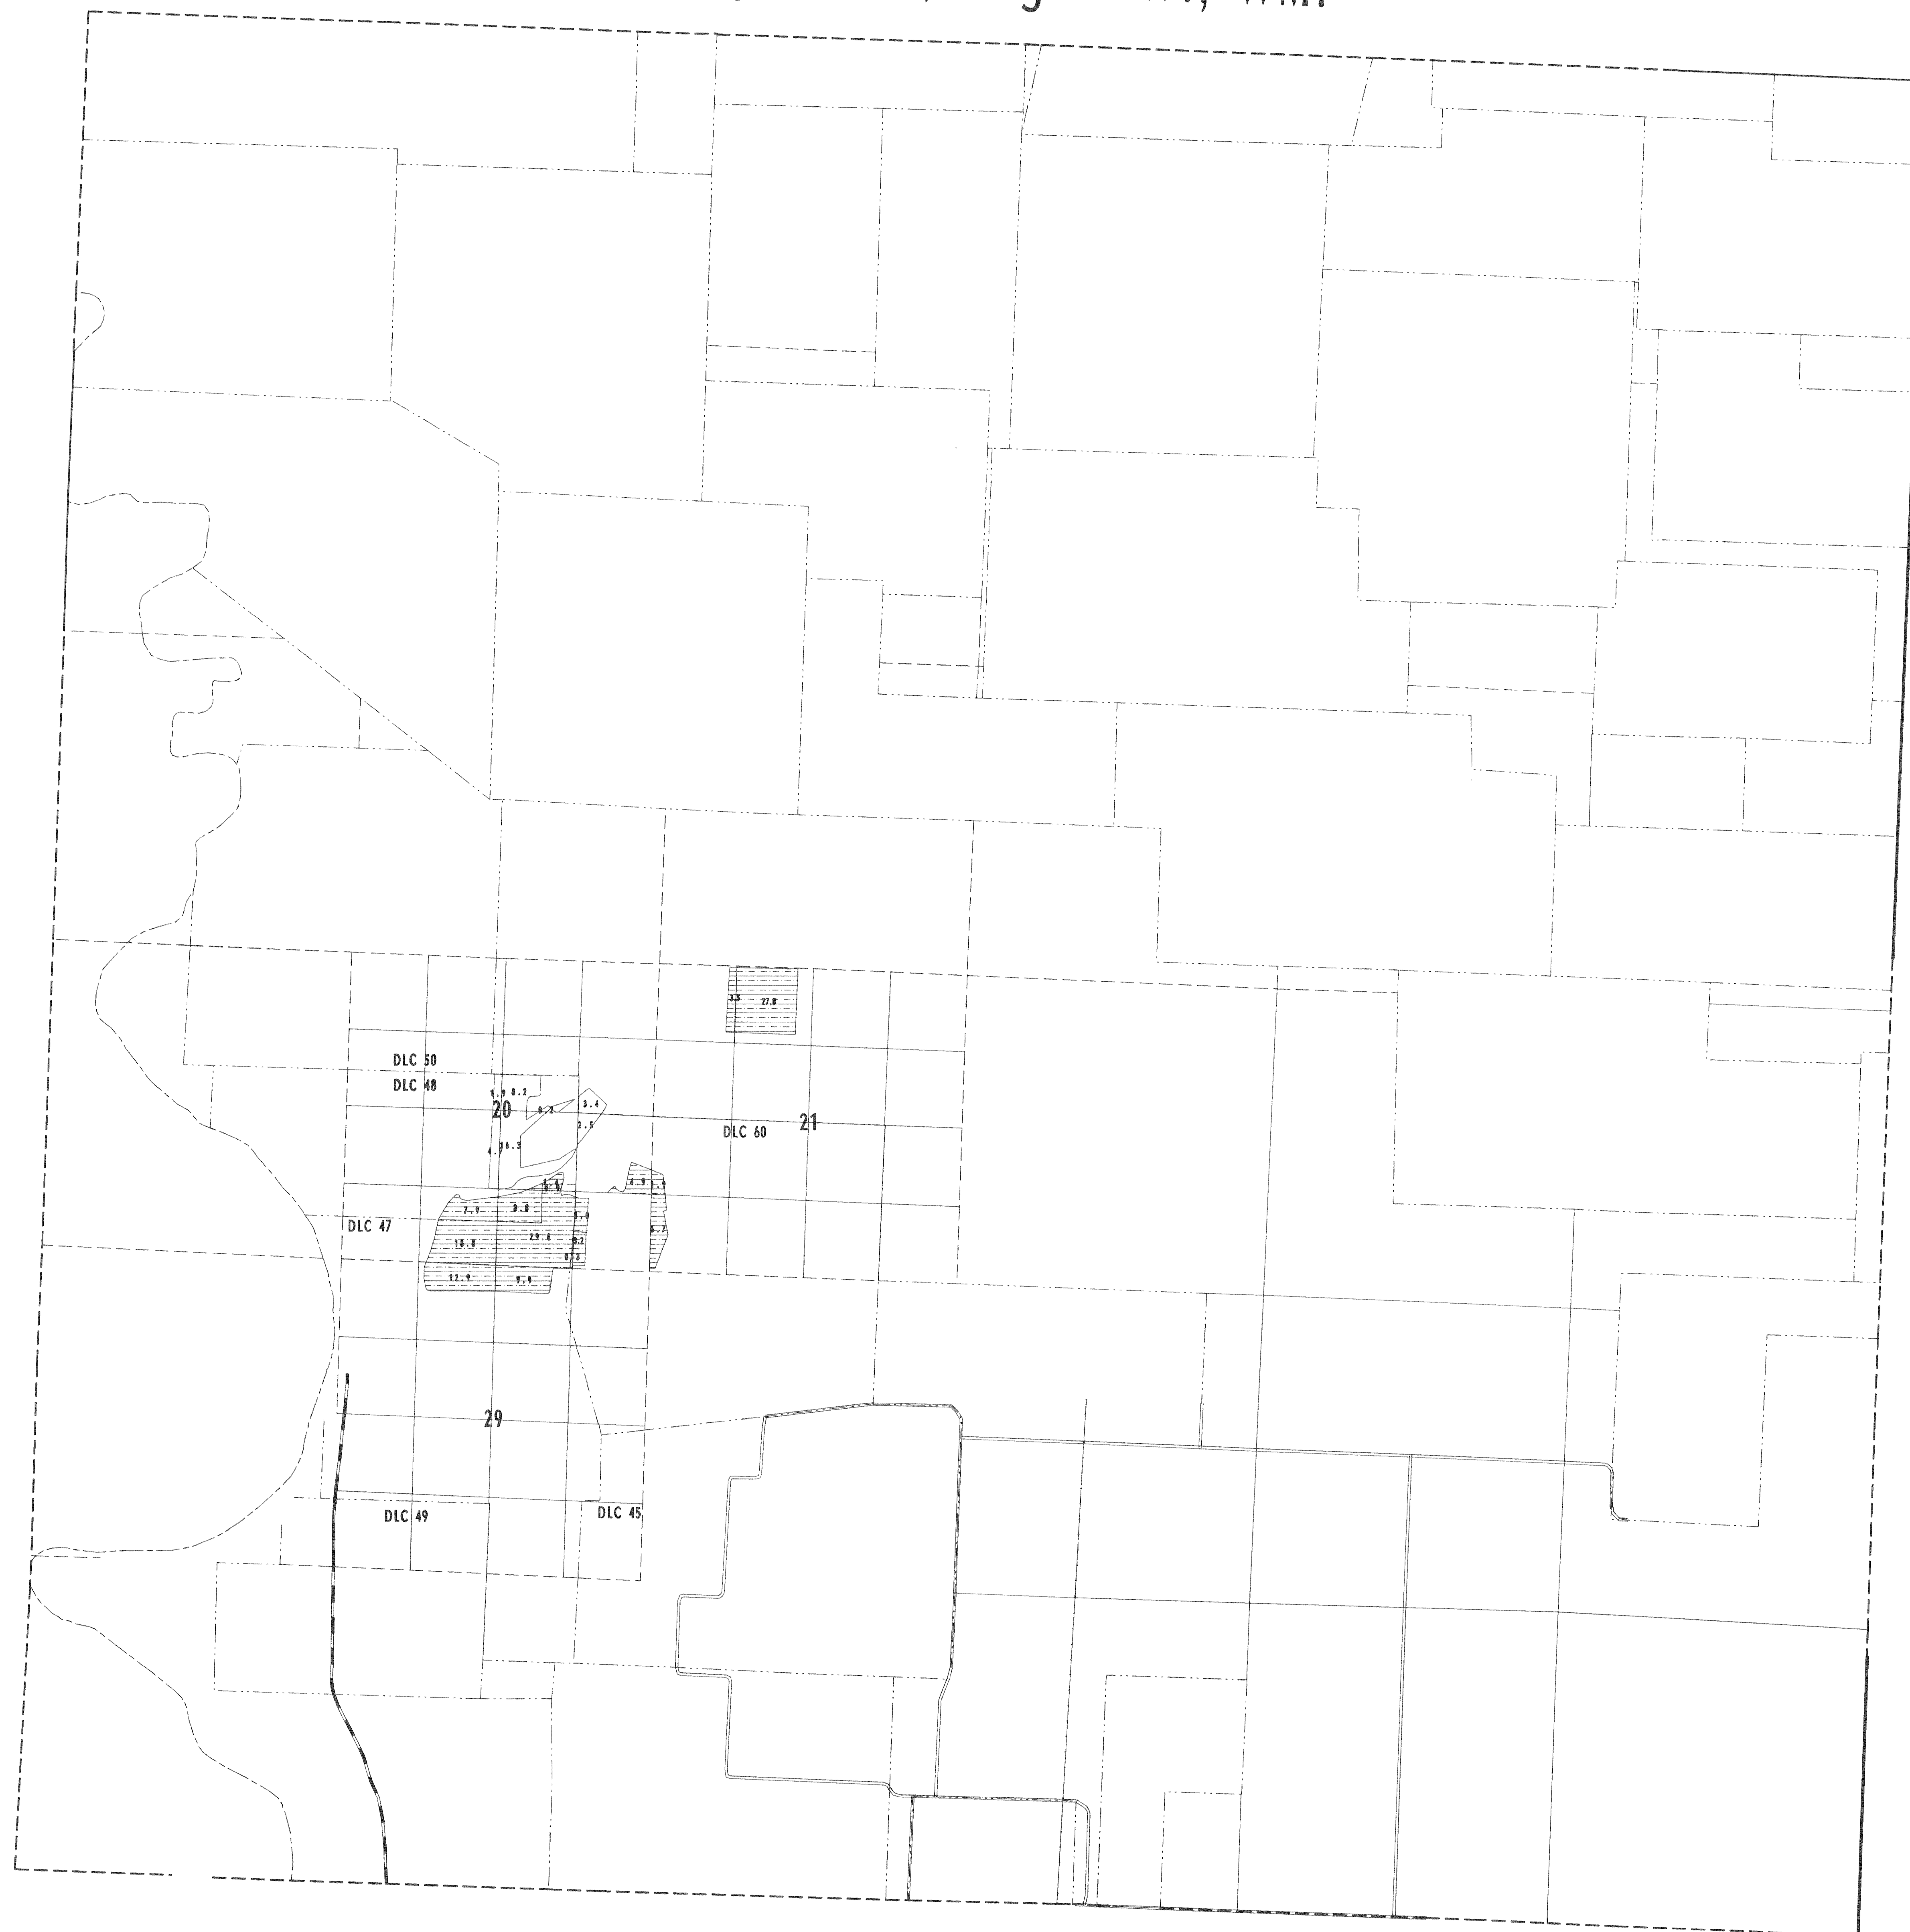





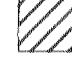




Twp. 12 S., Rng. 4 W., WM.



LEGEND

-  Permit 50921
-  Permit 37877
-  Permit 42759
-  Permit 43710
-  Permit 45980
-  Certificate 51599
-  Certificate 62148
-  Certificate 62281



SCALE 1" = 1320'

FINAL PROOF SURVEY

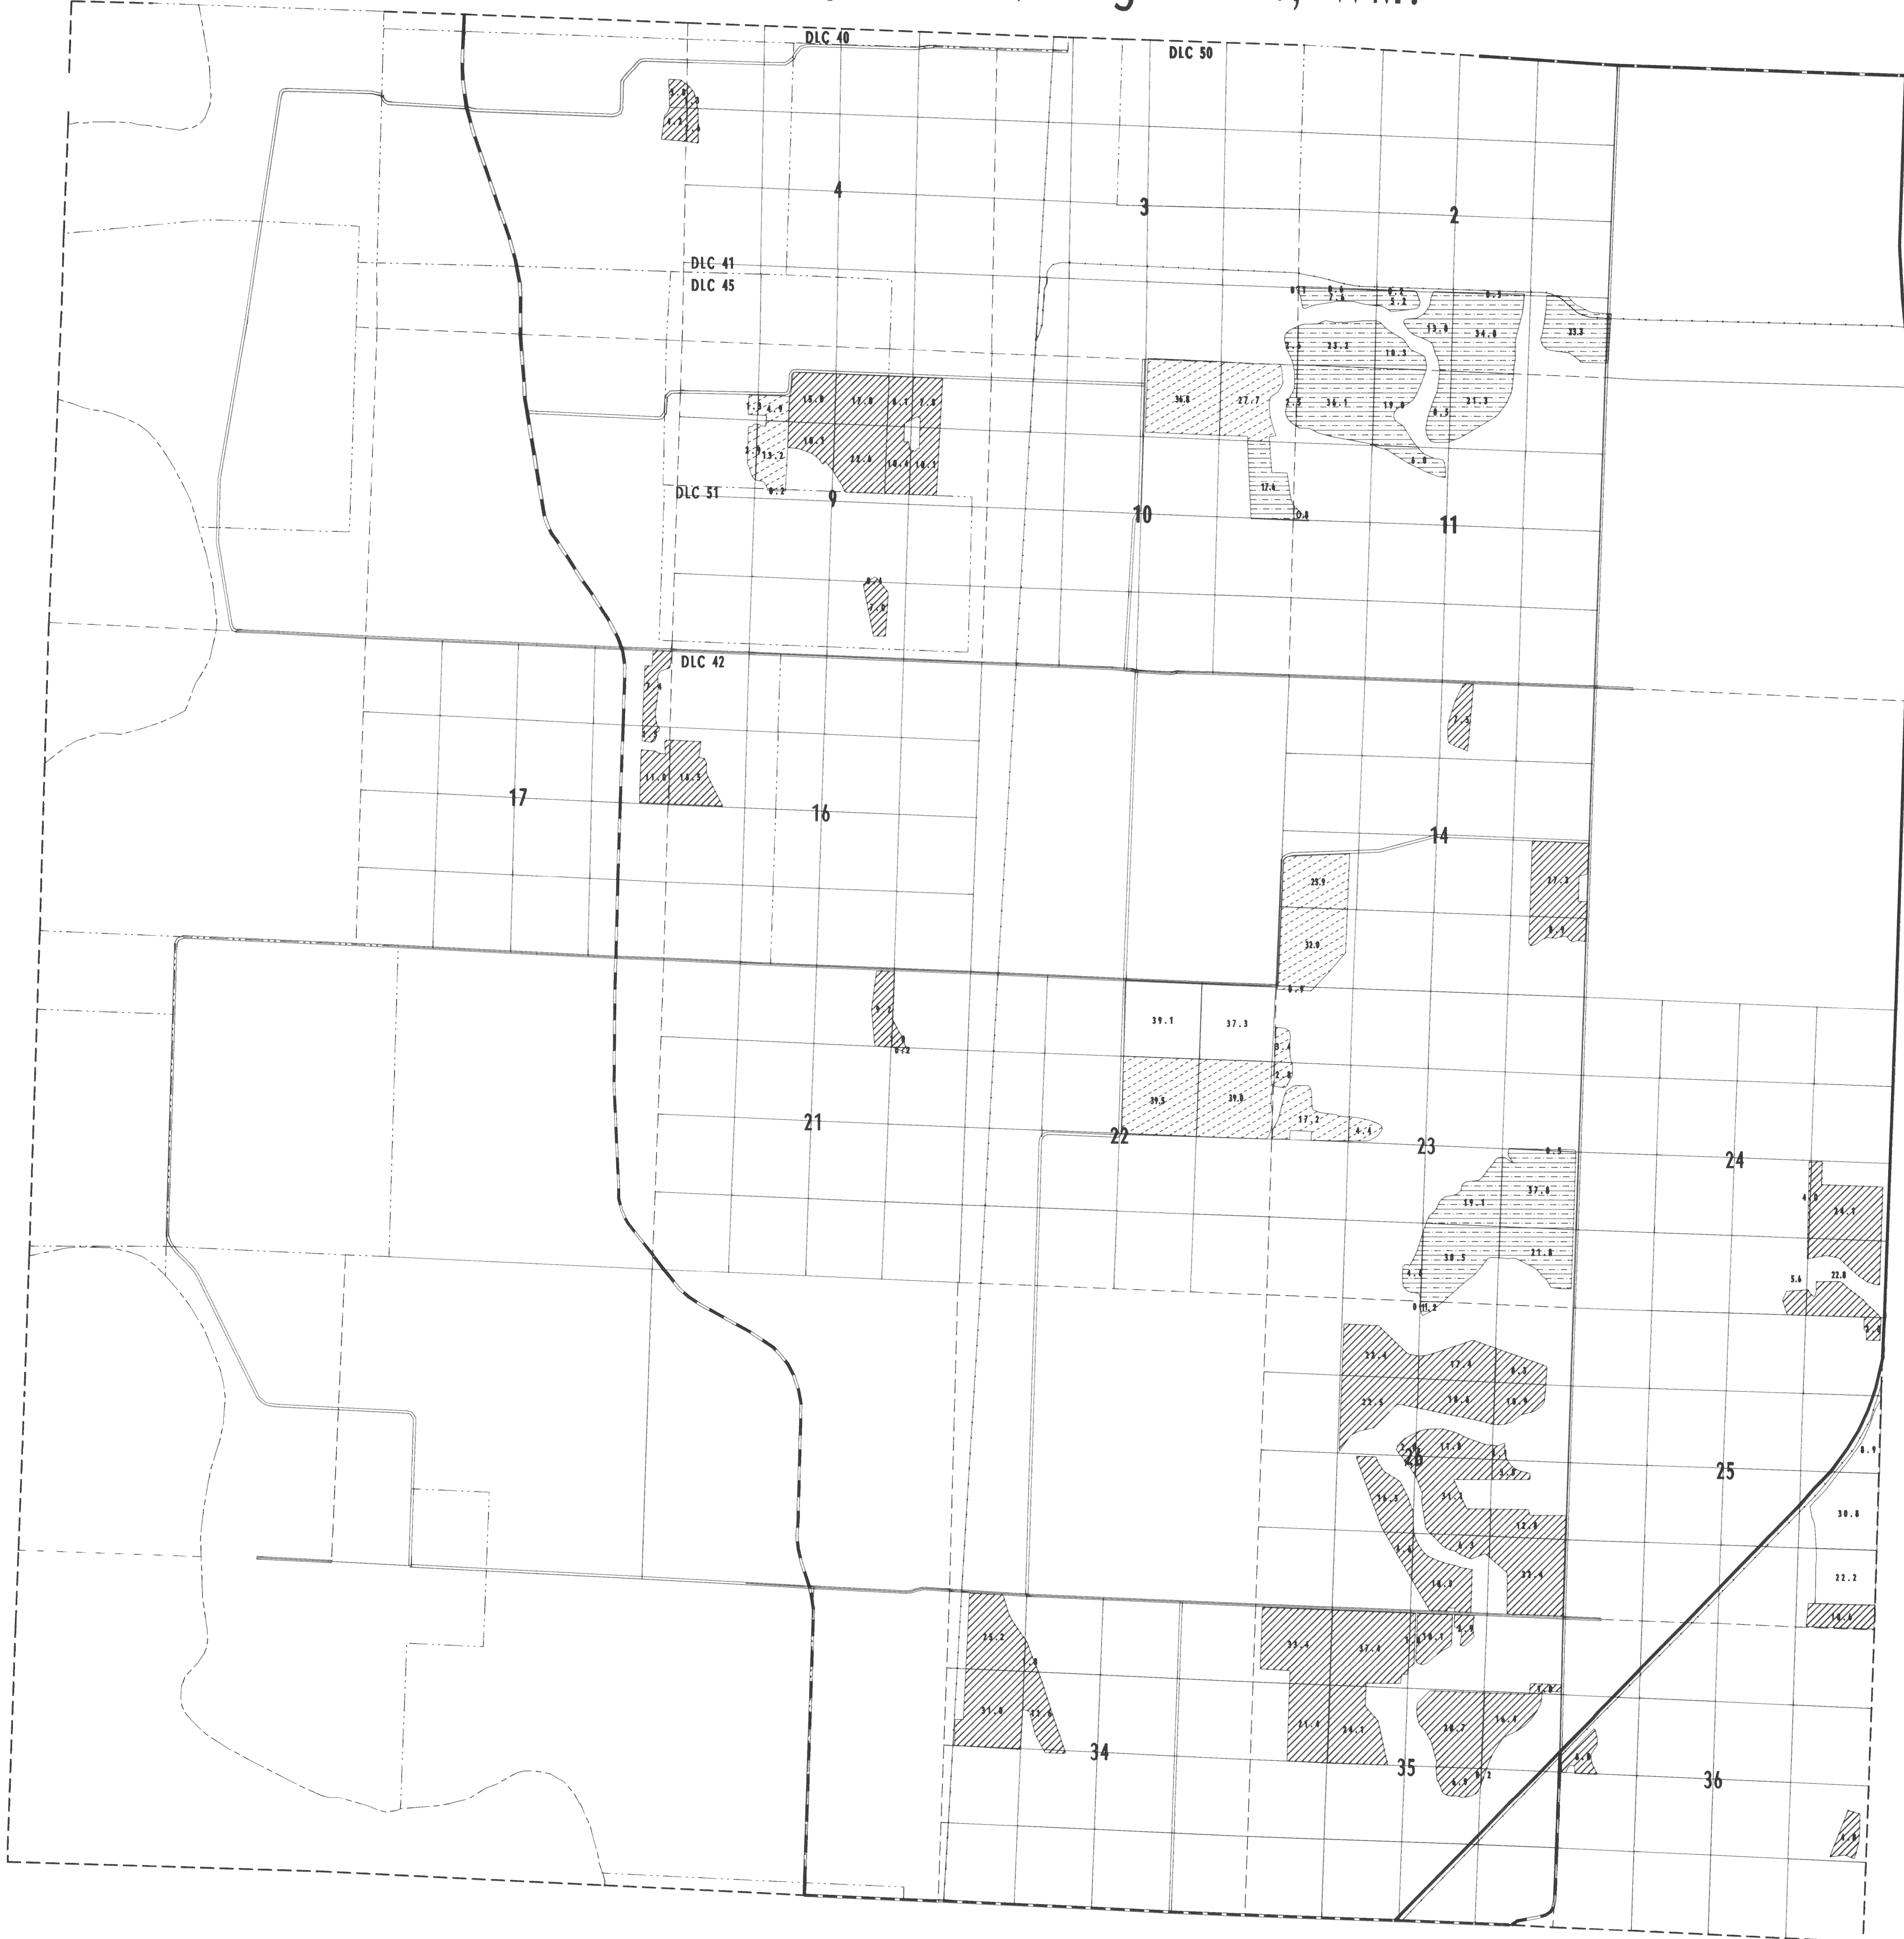
UNDER

Application 49527	Permit 37877
55400	42759
57947	43710
58932	45980
68824	50921





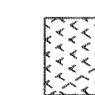

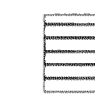

IN NAME OF
MUDDY CREEKS IRRIGATION PROJECT

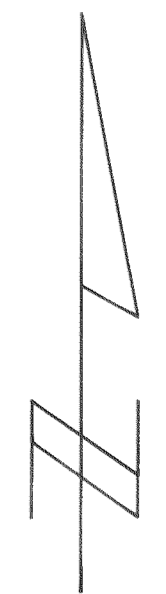
Surveyed 1993 By R.W.Klassen

Twp. 14 S., Rng. 4 W., WM.



LEGEND

-  Permit 55921
-  Permit 37877
-  Permit 42759
-  Permit 43710
-  Permit 45980
-  Certificate 51589
-  Certificate 62148
-  Certificate 62281



SCALE 1" = 1320'

FINAL PROOF SURVEY UNDER

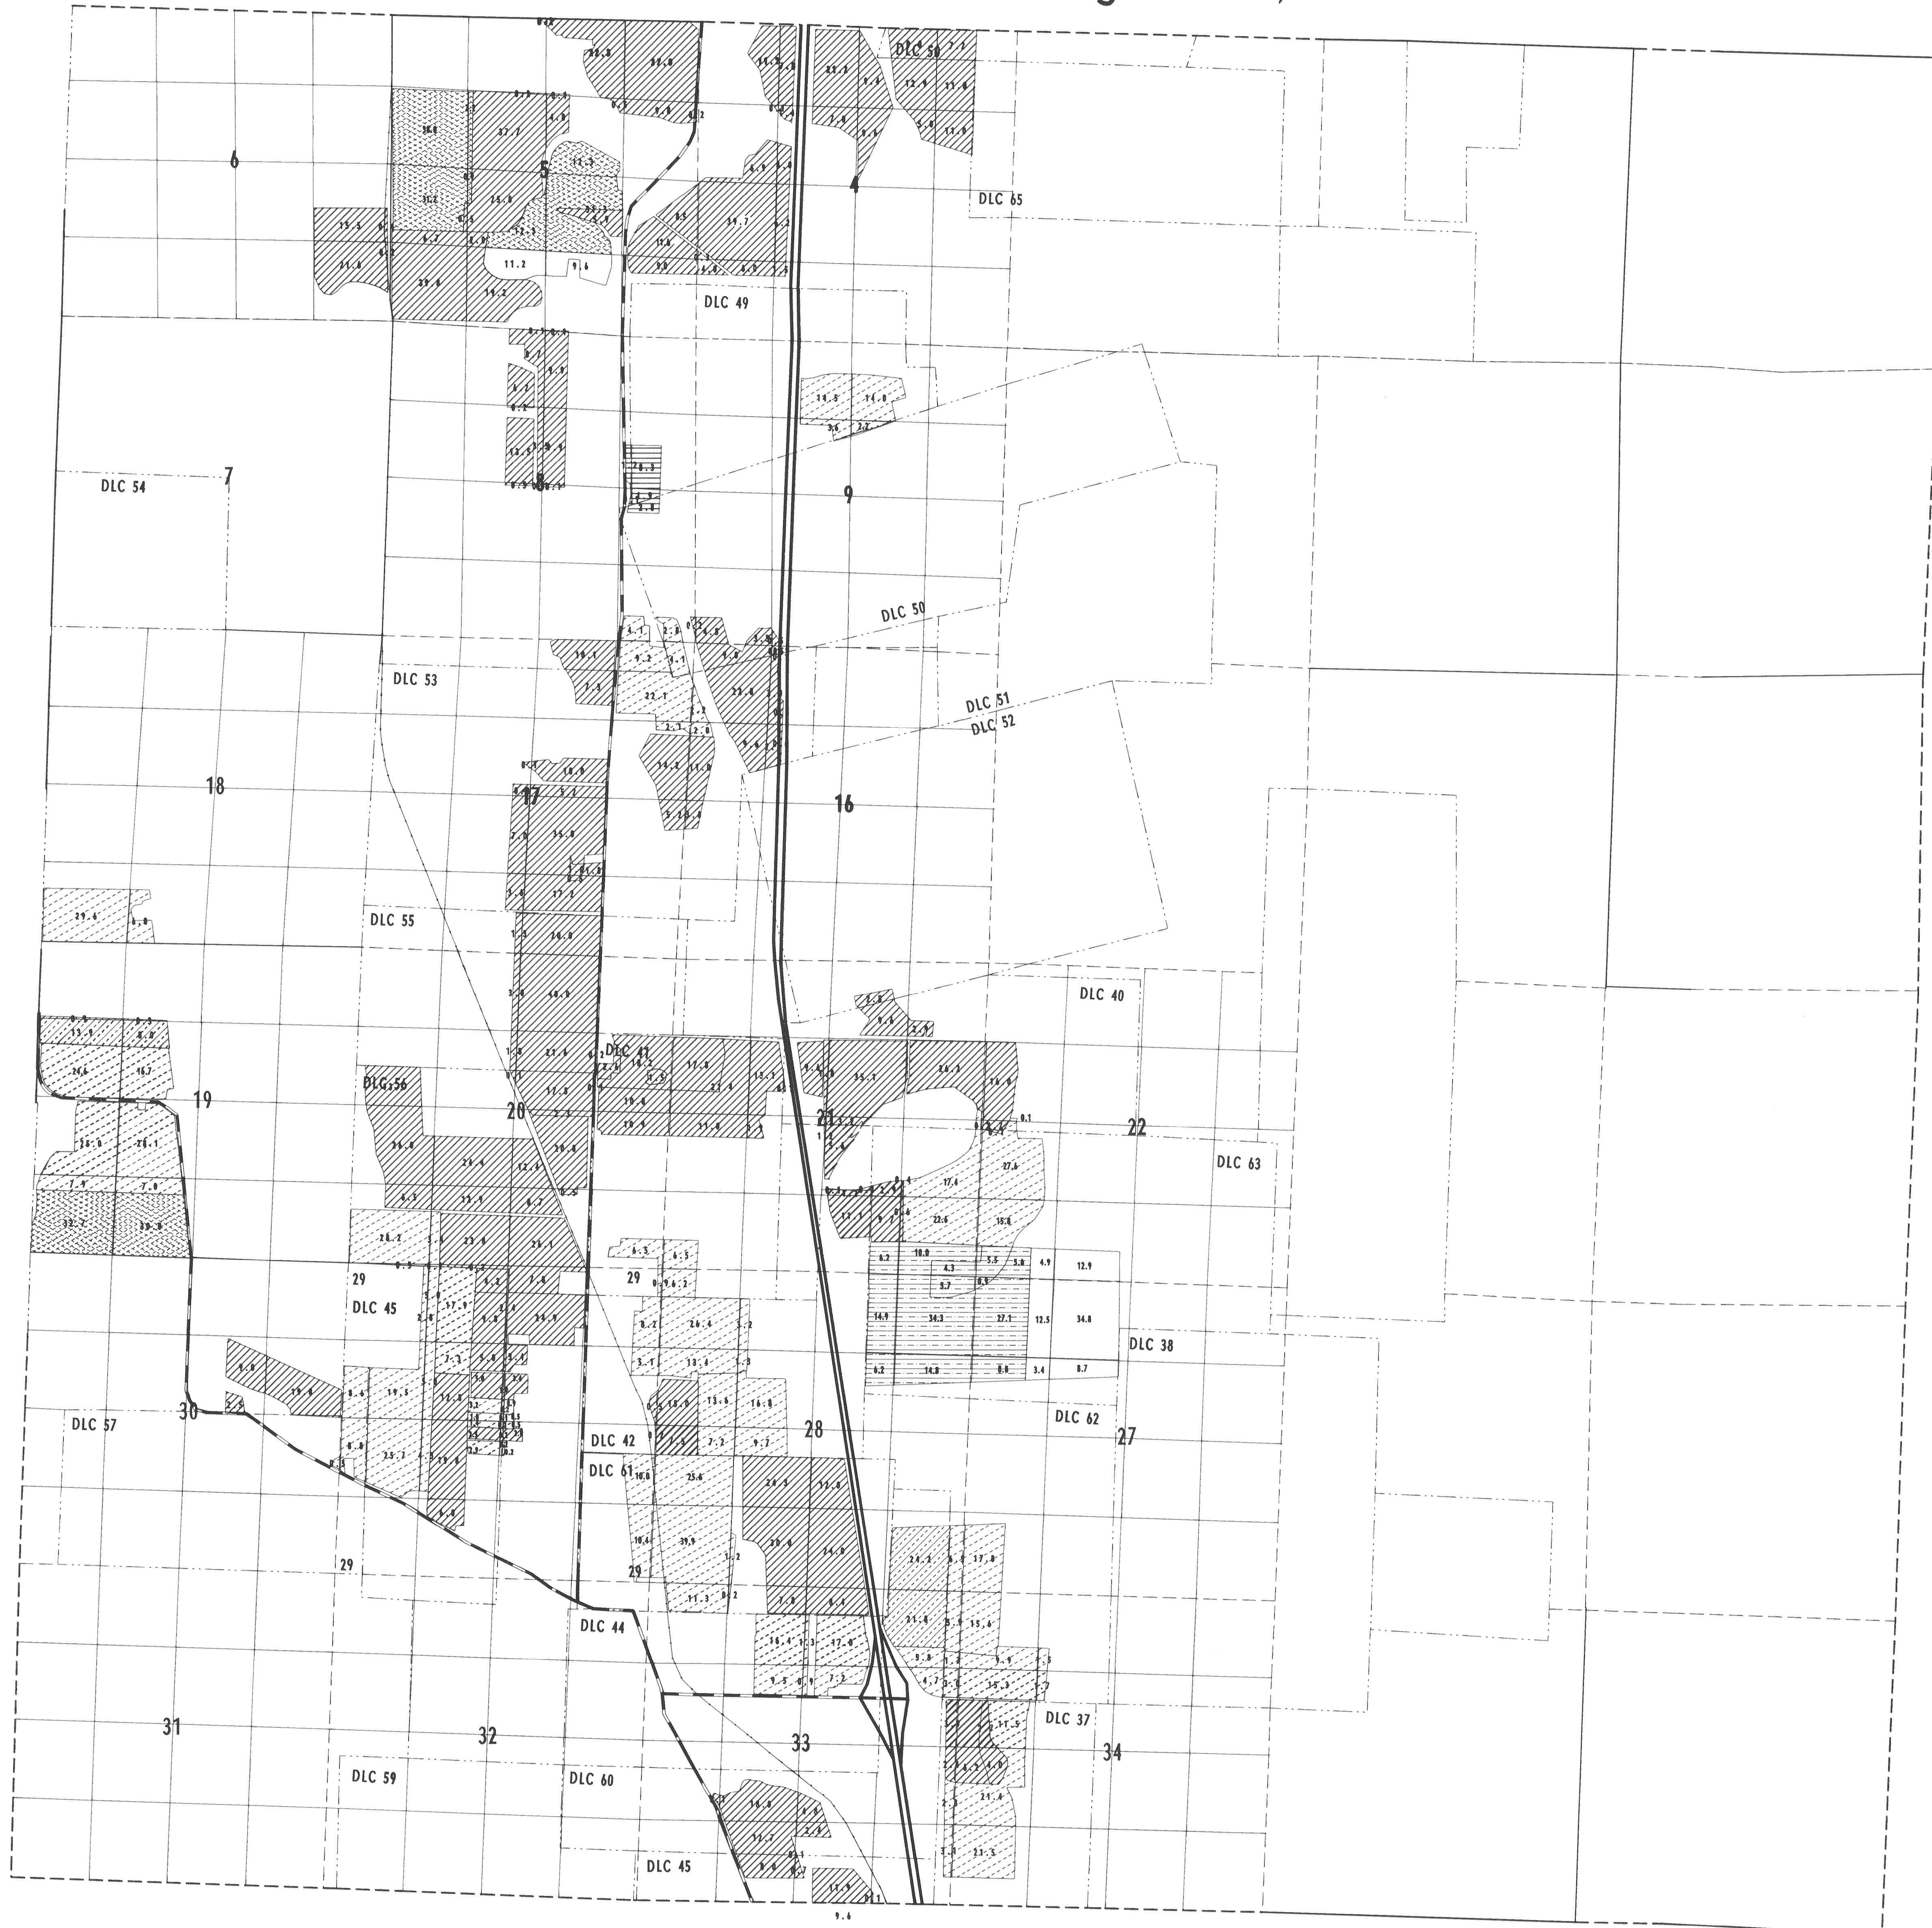
Application 49527	Permit 37877
55400	42759
57947	43710
58932	45980
68824	50921

IN NAME OF
MUDDY CREEKS IRRIGATION PROJECT




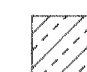


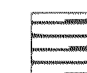

Surveyed 1993 By R.W.Klassen

Usernames: rquincy/306 11:05 AM
 Path: \\fs1\prod\m\l\lans\ml4s4w-fp

Twp. 16 S., Rng. 3 W., WM.



LEGEND

-  Permit 50921
-  Permit 37877
-  Permit 42759
-  Permit 43710
-  Permit 45980
-  Certificate 51599
-  Certificate 62148
-  Certificate 62281



SCALE 1" = 1320'

FINAL PROOF SURVEY

UNDER

Application 49527	Permit 37877
55400	42759
57947	43710
58932	45980
68824	50921

IN NAME OF
MUDDY CREEKS IRRIGATION PROJECT

Surveyed 1993 By R.W.Klassen

