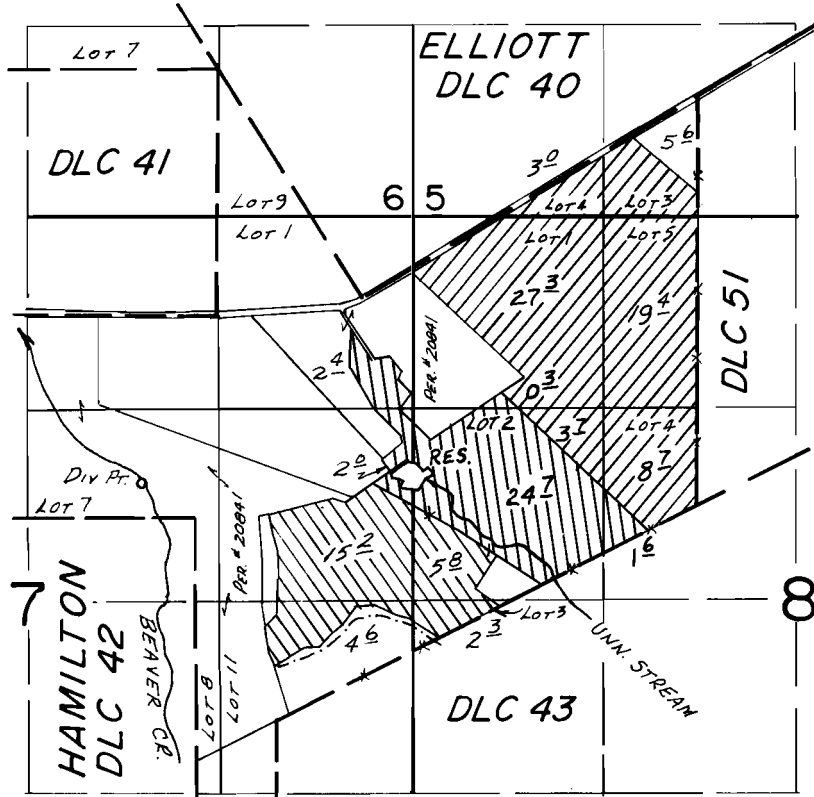

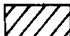
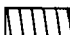


# T. 11 S., R. 1 W., W.M.



## FINAL PROOF SURVEY UNDER

-  TR. 3781
-  PER. 43922 (PRIMARY)
-  PER. 43922 (SUPPL.)

Transfer No. 3781  
 R-57813 R-7795  
 Application No. 57814 Permit No. 43922

IN NAME OF  
 KENNETH & BETH NICHOLS dba  
 NBAR S FRANCH

Surveyed MAY 28, 1982, by L. M. TOLL

Revised: 7-6-89

*JKL*  
*SLB*