


T. 2S., R. 38E., W. M.

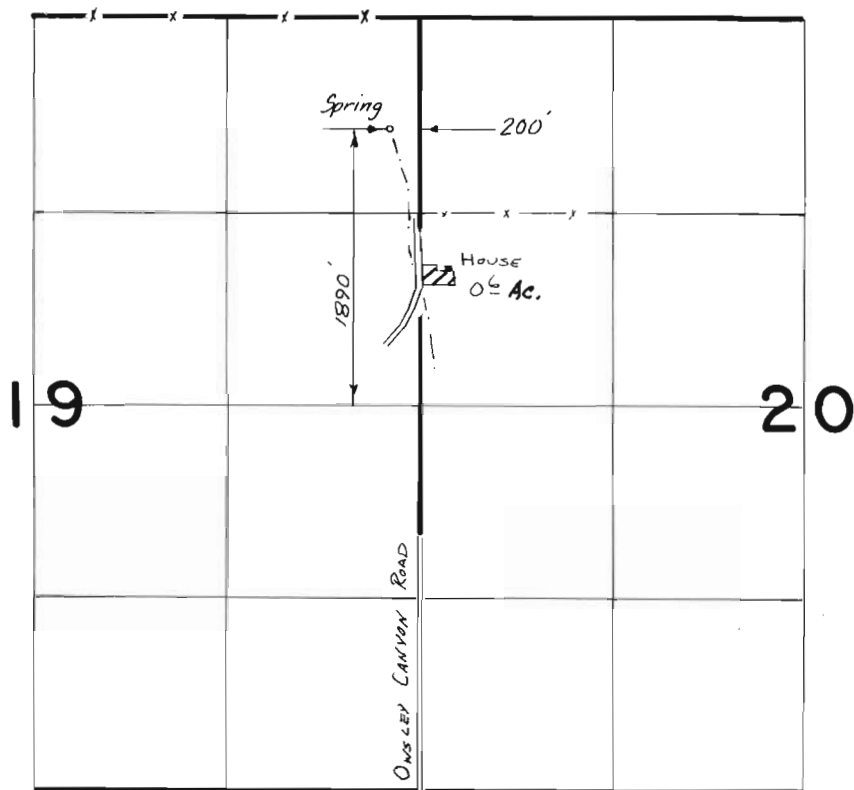

SCALE 1" = 1320'

FINAL PROOF SURVEY UNDER

Application No. **68996** Permit No. **49901**.....
IN NAME OF

RAYMOND W. & MARGARET A SIMONIS

Surveyed 7-25 1988, by K. L. Church.....