


T. 34 S., R. 4 W., W. M.

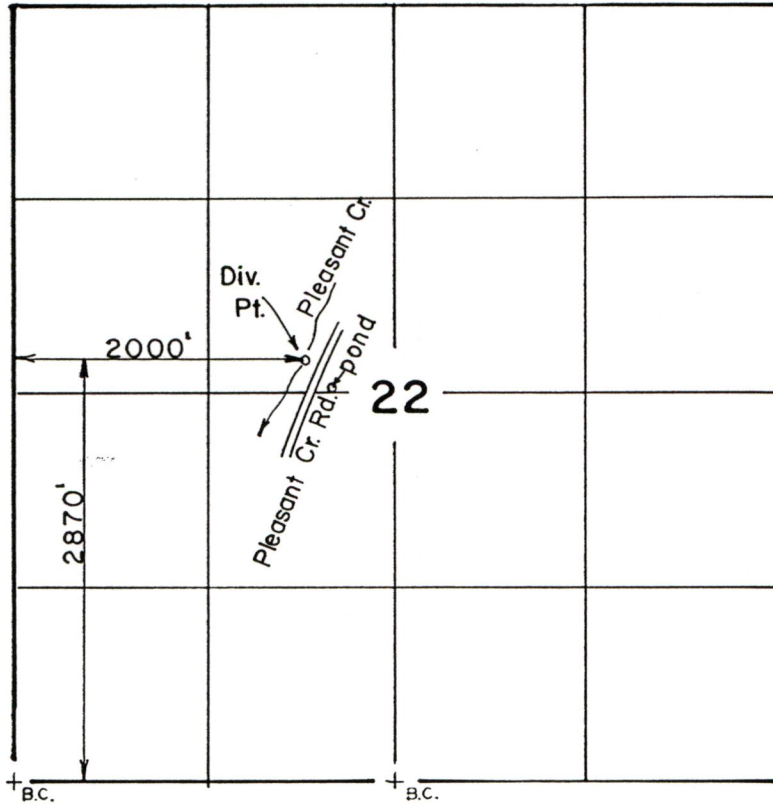

Scale: 1" = 1320

FINAL PROOF SURVEY
UNDER

TRANSFER NO. 4415

Application No. Permit No.
IN NAME OF

RONALD R. & DEBRA K. SIEBERT

Surveyed DEC. 4. 1990., by B. S. JAMES.