


T. 2S., R. 38E., W.M.

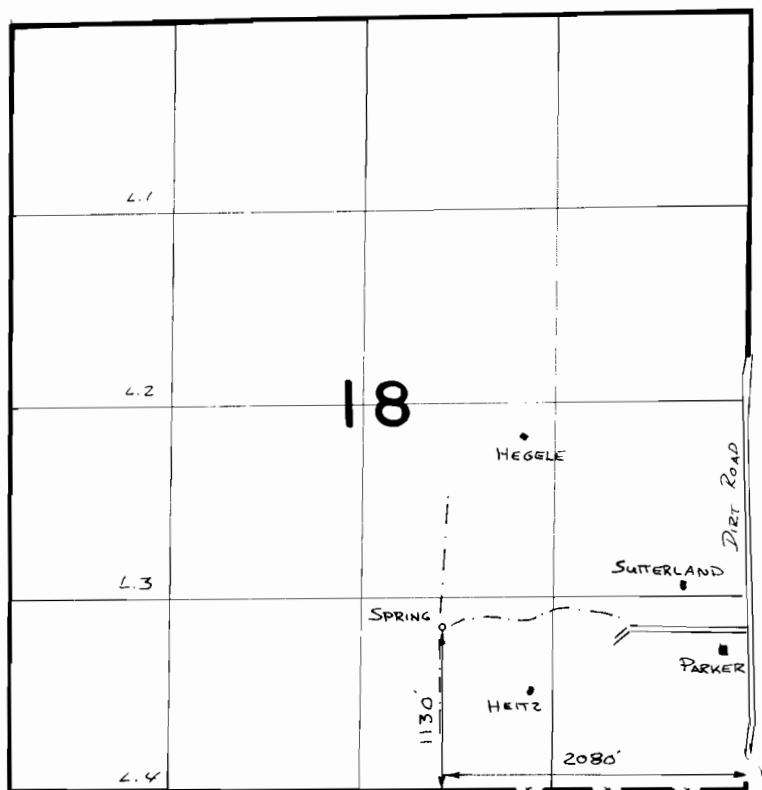

SCALE 1" = 1320'

FINAL PROOF SURVEY
UNDER

Application No. **48937** Permit No. **36645**
IN NAME OF

Surveyed 7-25-1989, by V.L. Church