


T.19 S., R. 27 E., W.M.

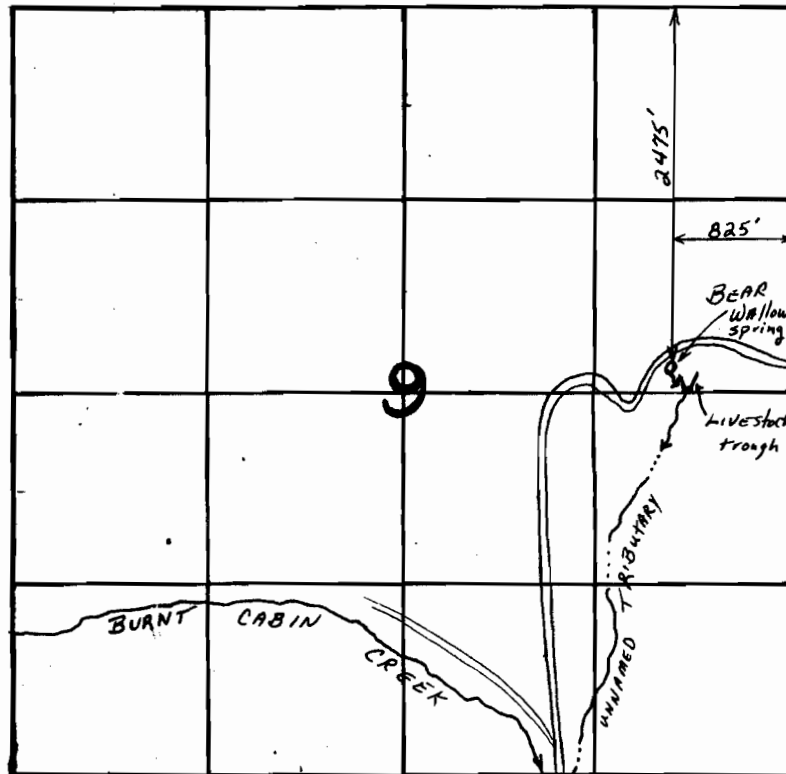

SCALE - 4" = 1 MILE

Application No.
Permit No.

60869
48522

RECEIVED

JUN 8 1983

WATER RESOURCES DEPT.
SALEM, OREGON