


T.21 S., R. 24 E., W.M.

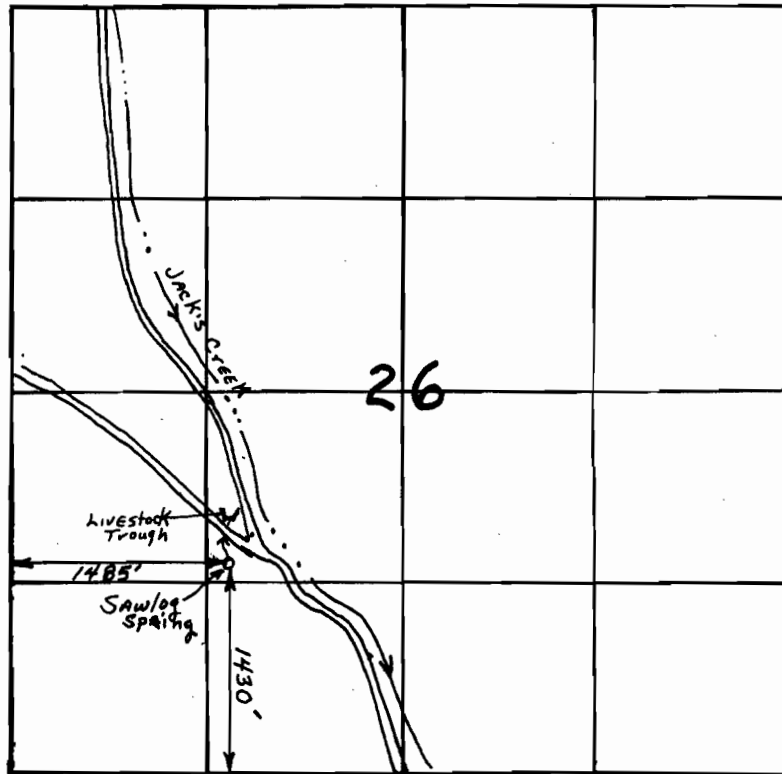

SCALE - 4" = 1 MILE

Application No. 60872

Permit No. 48525

RECEIVED
MAY 6 1985
WATER RESOURCES DEPT.
SALEM, OREGON