


T.18 S., R. 27 E., W.M.

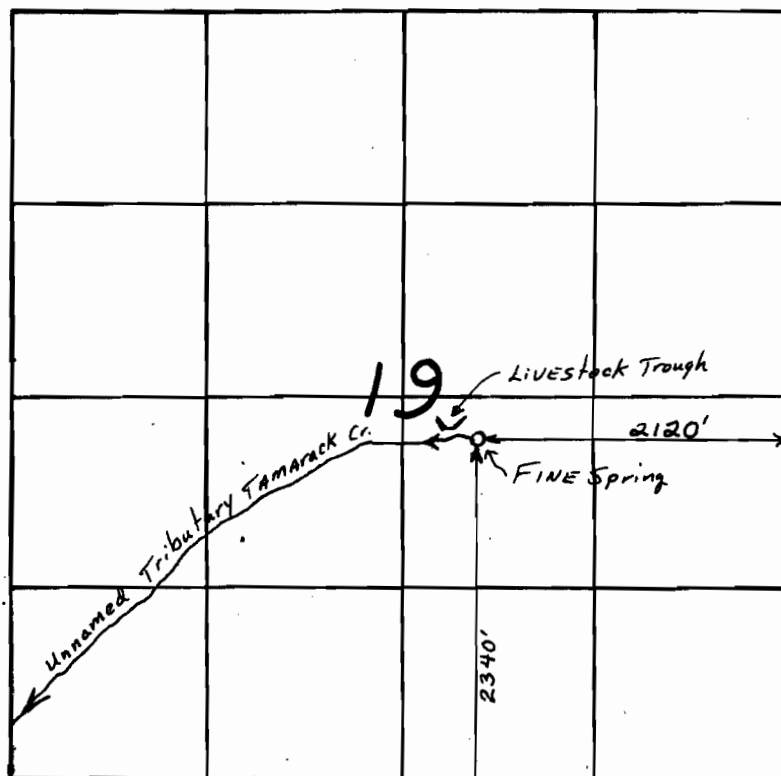

SCALE - 4" = 1 MILE

RECEIVED
MAY 6 1983
WATER RESOURCES DEPT.
SALEM, OREGON

Application No. 60878
Permit No. 48531