


scale 5.28 inches = 1 mile

T 15 S R 25 E Sec 9 SE 1/4 of SW 1/4

BOX SPRING

Application No. **62706**
R-62707
Permit No. **48426**
R 9697

SECTION 9

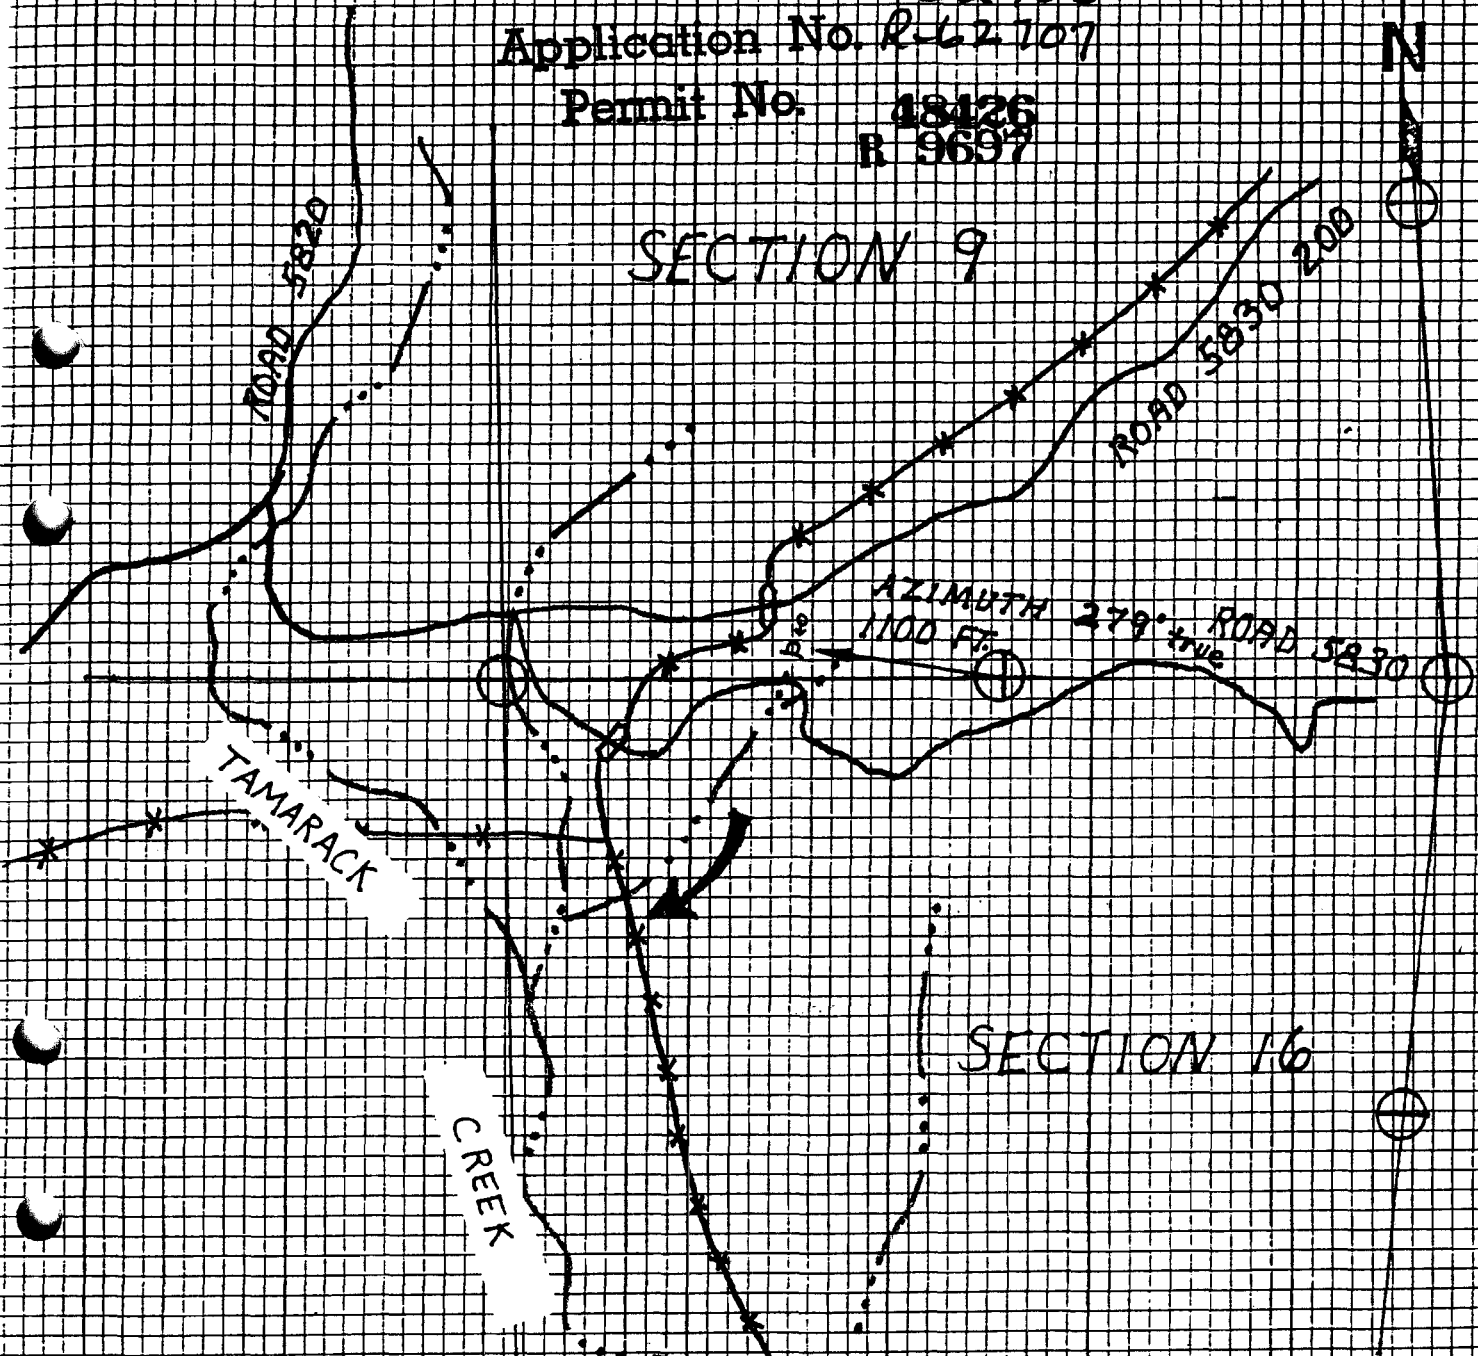

SECTION 16

DIRECTION OF FLOW

RECEIVED

SEP 11 1981

WATER RESOURCES DEPT
SALEM, OREGON

KEY

- RESERVOIR
- ♀ SPRING
- - - INTERMITTENT STREAM
- ROAD
- ⊕ MONUMENTED LAND LINE
- * ALLOTMENT FENCE

field work by *J. Tibbatts & J. Vahn*

date *4-15-81*

platted by *J. Tibbatts*

75289 48426