


RECEIVED

SEP 11 1981

WATER RESOURCES DEPT
SALEM, OREGON

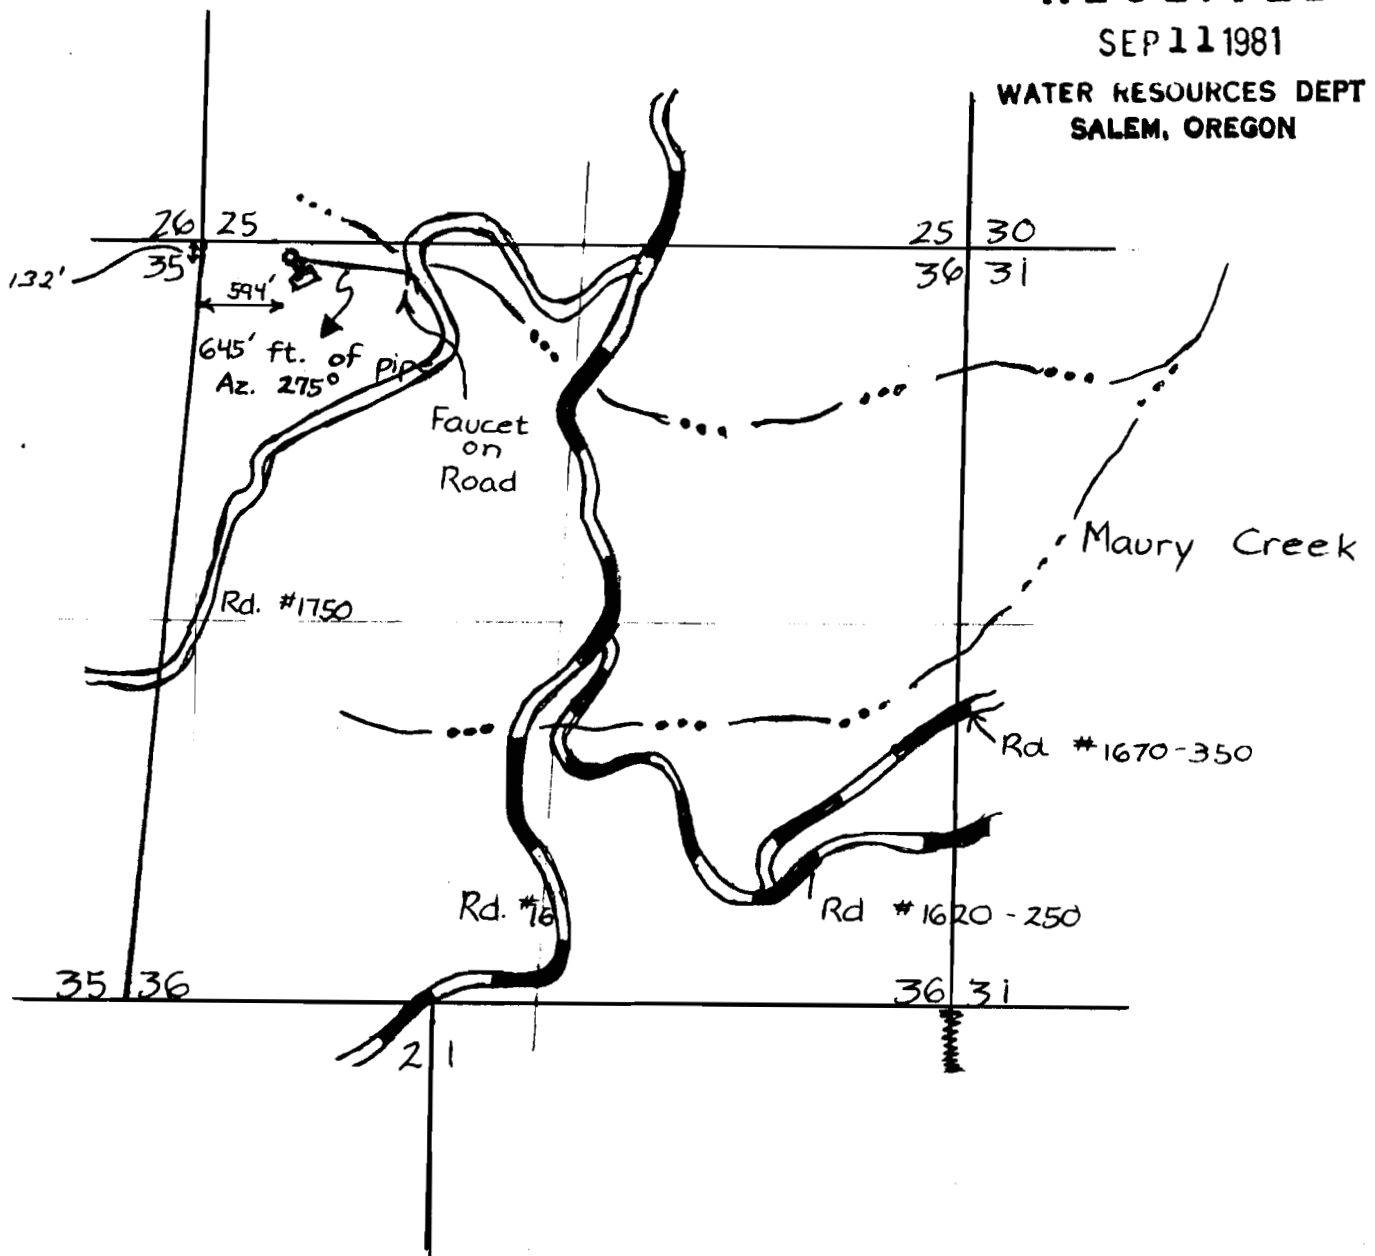

Old Mill Springs

NW 1/4, NW 1/4, Sec. 36, T17S, R, 20E, W.M.

Scale : 4" = 1 mile

Application No. 62713

Permit No. 48646

C-75290

48646