


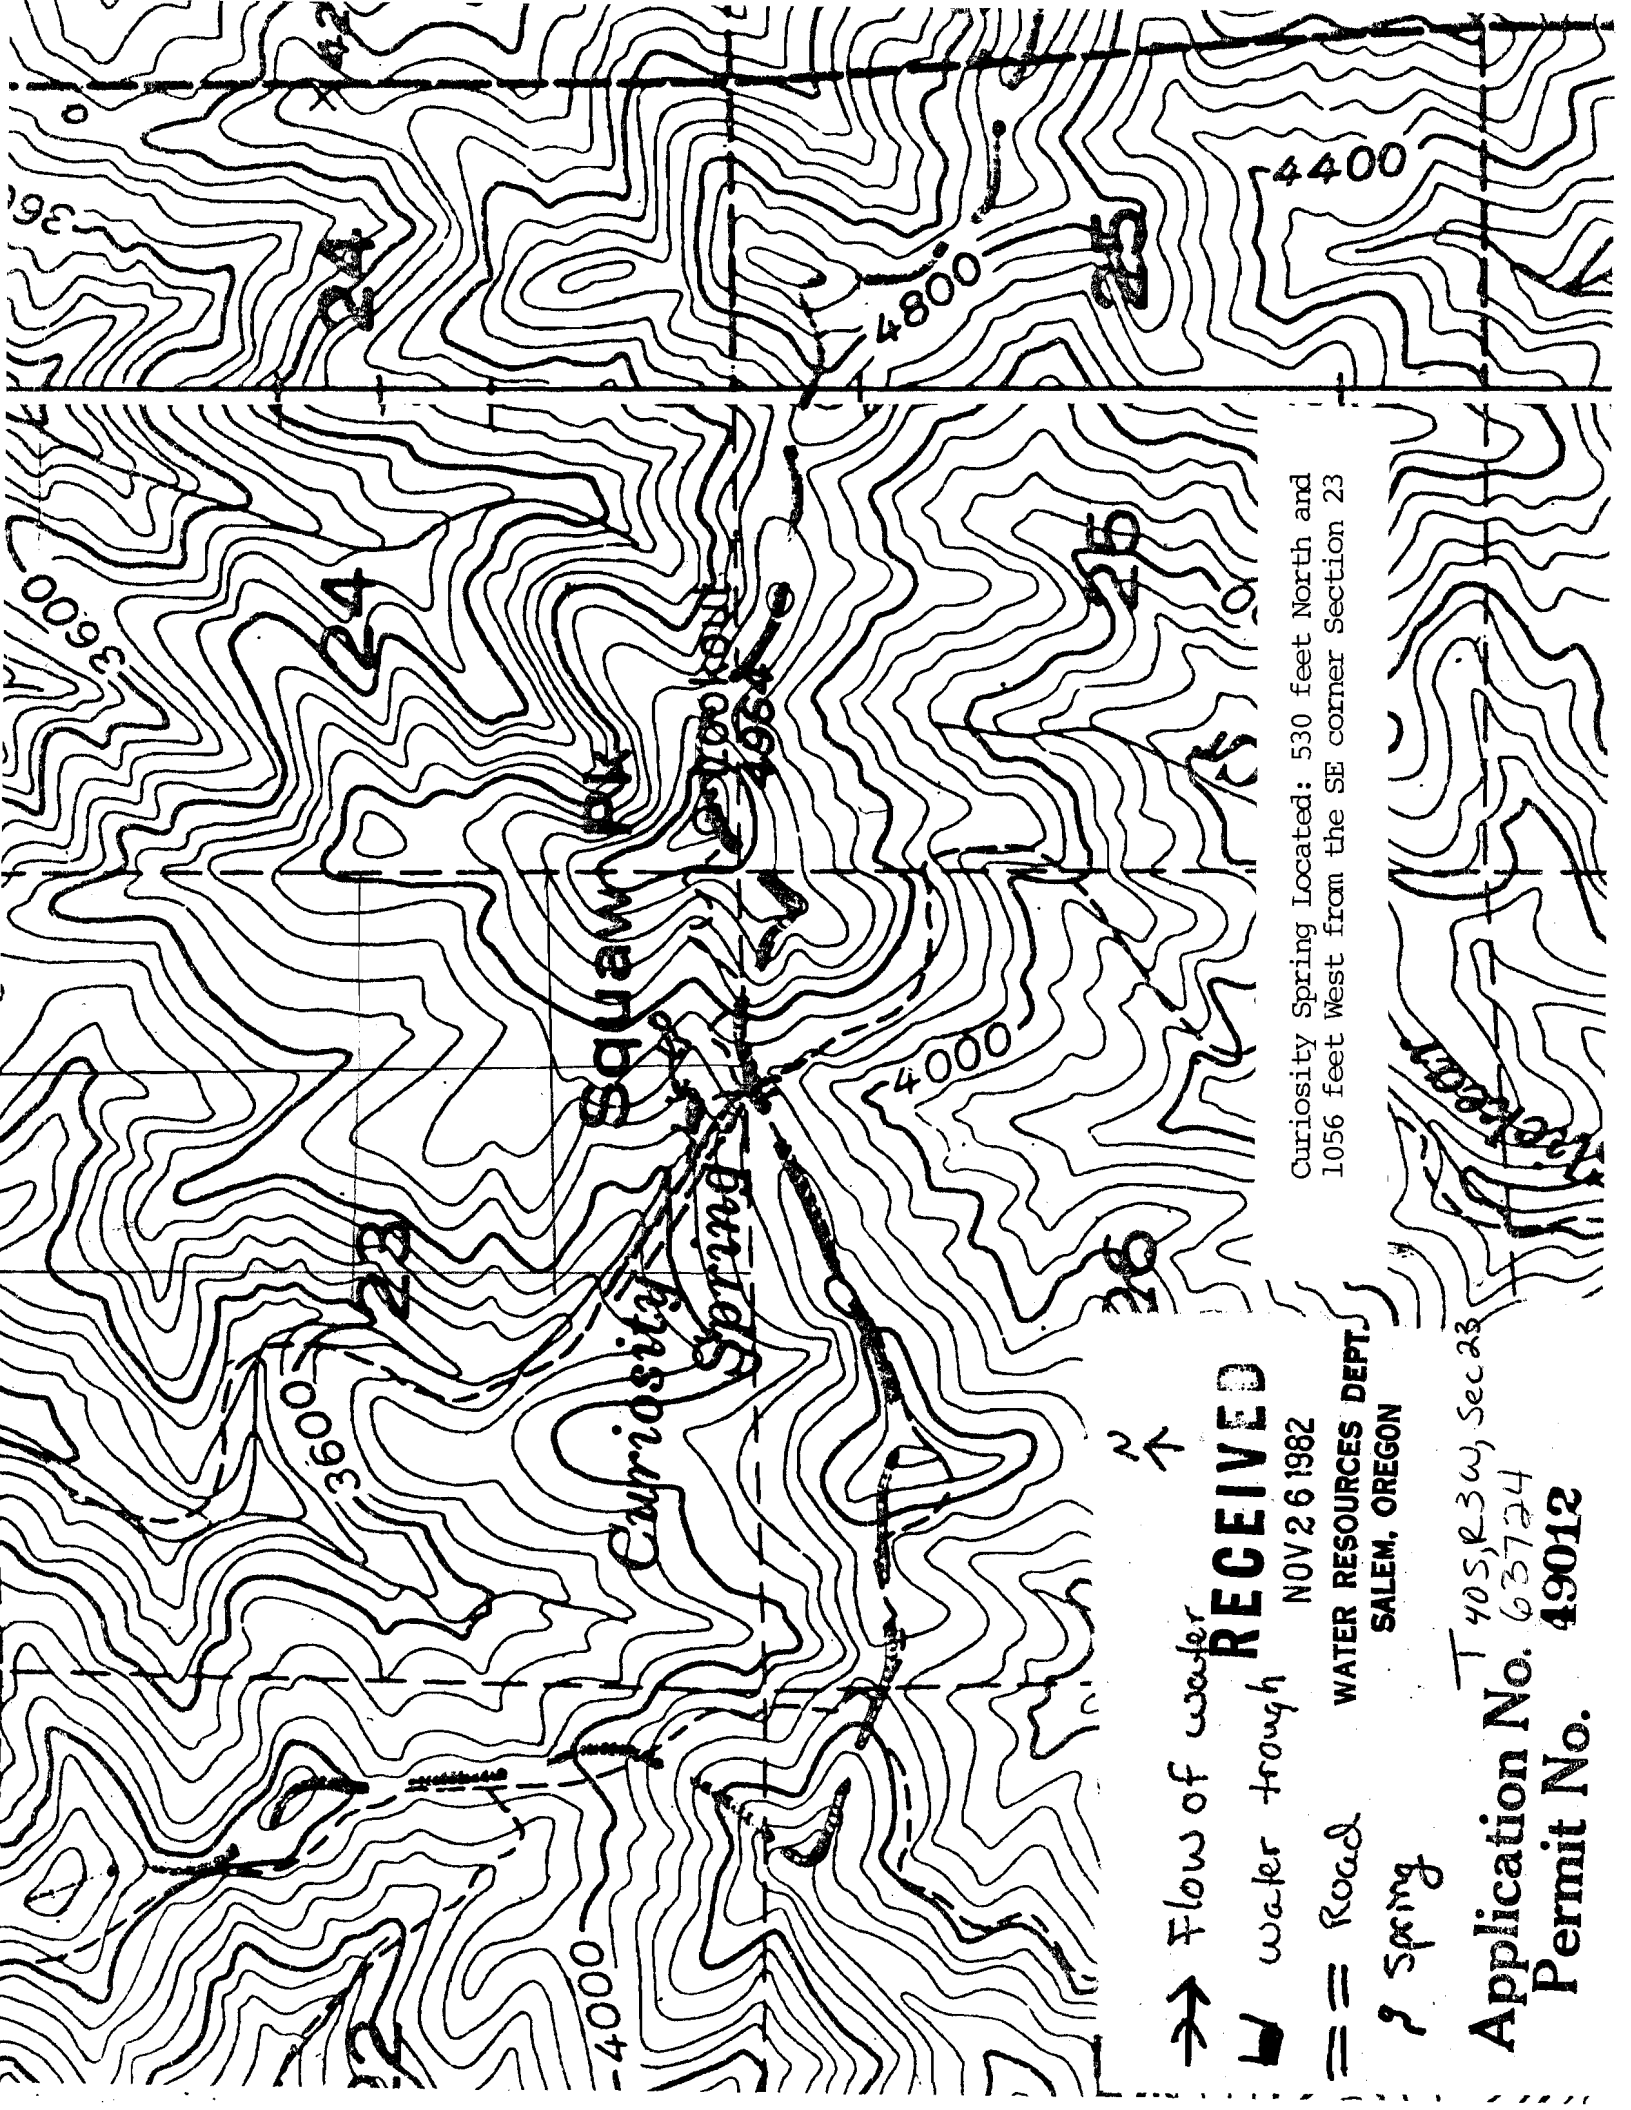

Curiosity Spring Located: 530 feet North and 1056 feet West from the SE corner Section 23

→ Flow of water
└─ water trough
== Road
○ Spring

RECEIVED

NOV 26 1982

WATER RESOURCES DEPT.
SALEM, OREGON

T 405, R 3W, Sec 23
Application No. 63724
Permit No. 49012